

Dilling™

GROUP, INC

INDUSTRIAL PROCESS GROUP DIVISION

111 EAST MILDRED STREET, PO BOX 47, LOGANSPORT IN 46947-0047

REGIONAL OFFICES:

LOGANSPORT, IN WARSAW, IN FORT WAYNE, IN INDIANAPOLIS, IN BOWLING GREEN, KY CHARLESTON, TN JOHNSON CITY, TN

www.dillinggroup.com info@dillinggroup.com

A **COMFORT SYSTEMS USA** Company



This material is the property of the Dilling Group, Inc. No rights are granted to use such material for any other purpose than the furnishing of services & supplies.



REVISIONS:			
REV	BY	DATE	DESCRIPTION
00	BAJ	2021-03-03	RELEASE FOR CONST.
01	BAJ	2021-04-21	AS BUILT
DATE:		DESIGNED BY:	
2021-02-18		BA JOHNSON	
DRAWN BY:		REVIEWED BY:	
BA JOHNSON		JL ARNOLD	
UL 508A DESIGN: NO			
UL 698A DESIGN: NO			
DILLING GROUP PROJECT NUMBER: D215218			
CUSTOMER PROJECT/PO NUMBER: CR2101G 27289			
WAYNE FARMS, UNION AL REFRIGERATION CONTROL SYSTEM EVAPORATOR PANEL			
COVER PAGE			

DRAWING NUMBER: 2260-D-000
© 2021, Dilling Group, Inc.

2022-10-17 08:27 AM Z:\IPG DATA\IGI PROJECTS\2021\CLOSED\D215218 - REPUB.LC - Wayne Farms Evaporator Control Panel, Union Springs AL - Job D215218 - 2022-09-07.dwg



EVAPORATOR CONTROL PANEL, UNION AL

ELECTRICAL
DRAWING INDEX

SHEET #	DRAWING #	DESCRIPTION
000	2260-D-000	COVER PAGE
001	2260-D-001	DRAWING INDEX
002	2260-D-002	GENERAL ELECTRICAL SYMBOLS AND TECHNICAL NOTES
003	2260-D-003	GENERAL ELECTRICAL INSTALLATION SPECIFICATIONS AND NOTES
004	2260-D-004	480V AC POWER DISTRIBUTION
005	2260-D-005	480V AC POWER DISTRIBUTION
006	2260-D-006	480V AC POWER DISTRIBUTION
007	2260-D-007	FUTURE EXPANSION
008	2260-D-008	120V AC POWER DISTRIBUTION
009	2260-D-009	120V AC POWER DISTRIBUTION


SHEET #	DRAWING #	DESCRIPTION
010	2260-D-010	24V DC POWER DISTRIBUTION
011	2260-D-011	24V DC POWER DISTRIBUTION
012	2260-D-012	COMPACT LOGIX RACK 00 SLOTS 00 AND 01
013	2260-D-013	COMPACT LOGIX RACK 00 SLOTS 02 AND 03
014	2260-D-014	COMPACT LOGIX RACK 00 SLOTS 04 AND 05
015	2260-D-015	COMPACT LOGIX RACK 00 SLOT 06 AND FDP
016	2260-D-016	COMPACT LOGIX RACK 00 SLOT 07
017	2260-D-017	LOCAL ETHERNET NETWORK LAYOUT
018	2260-D-018	CONTROL PANEL LAYOUT
019	2260-D-019	CONTROL ENCLOSURE LAYOUT

This material is the property of the Dilling Group, Inc. No rights are granted to use such material for any other purpose than the furnishing of services & supplies.



REVISIONS:			
REV	BY	DATE	DESCRIPTION
00	BAJ	2021-03-03	RELEASE FOR CONST.
01	BAJ	2021-04-21	AS BUILT
DATE:		DESIGNED BY:	
2021-02-18		BA JOHNSON	
DRAWN BY:		REVIEWED BY:	
BA JOHNSON		JL ARNOLD	
UL 508A DESIGN: NO			
UL 698A DESIGN: NO			
DILLING GROUP PROJECT NUMBER: D215218			
CUSTOMER PROJECT/PO NUMBER: CR2101G 27289			
WAYNE FARMS, UNION AL REFRIGERATION CONTROL SYSTEM EVAPORATOR PANEL			
DRAWING INDEX			
DRAWING NUMBER: 2260-D-001			
© 2021, Dilling Group, Inc.			

2022-10-17 08:29 AM Z:\IPG DATA\IGI PROJECTS\2021\CLOSED\D215218 - REPUBLIC - Wayne Farms Evaporator Control Panel, Union Springs AL\CA0\2260-D Rev.02 - REPUBLIC - Wayne Farms Evaporator Control Panel, Union Springs AL - Job D215218 - 2022-09-07.dwg

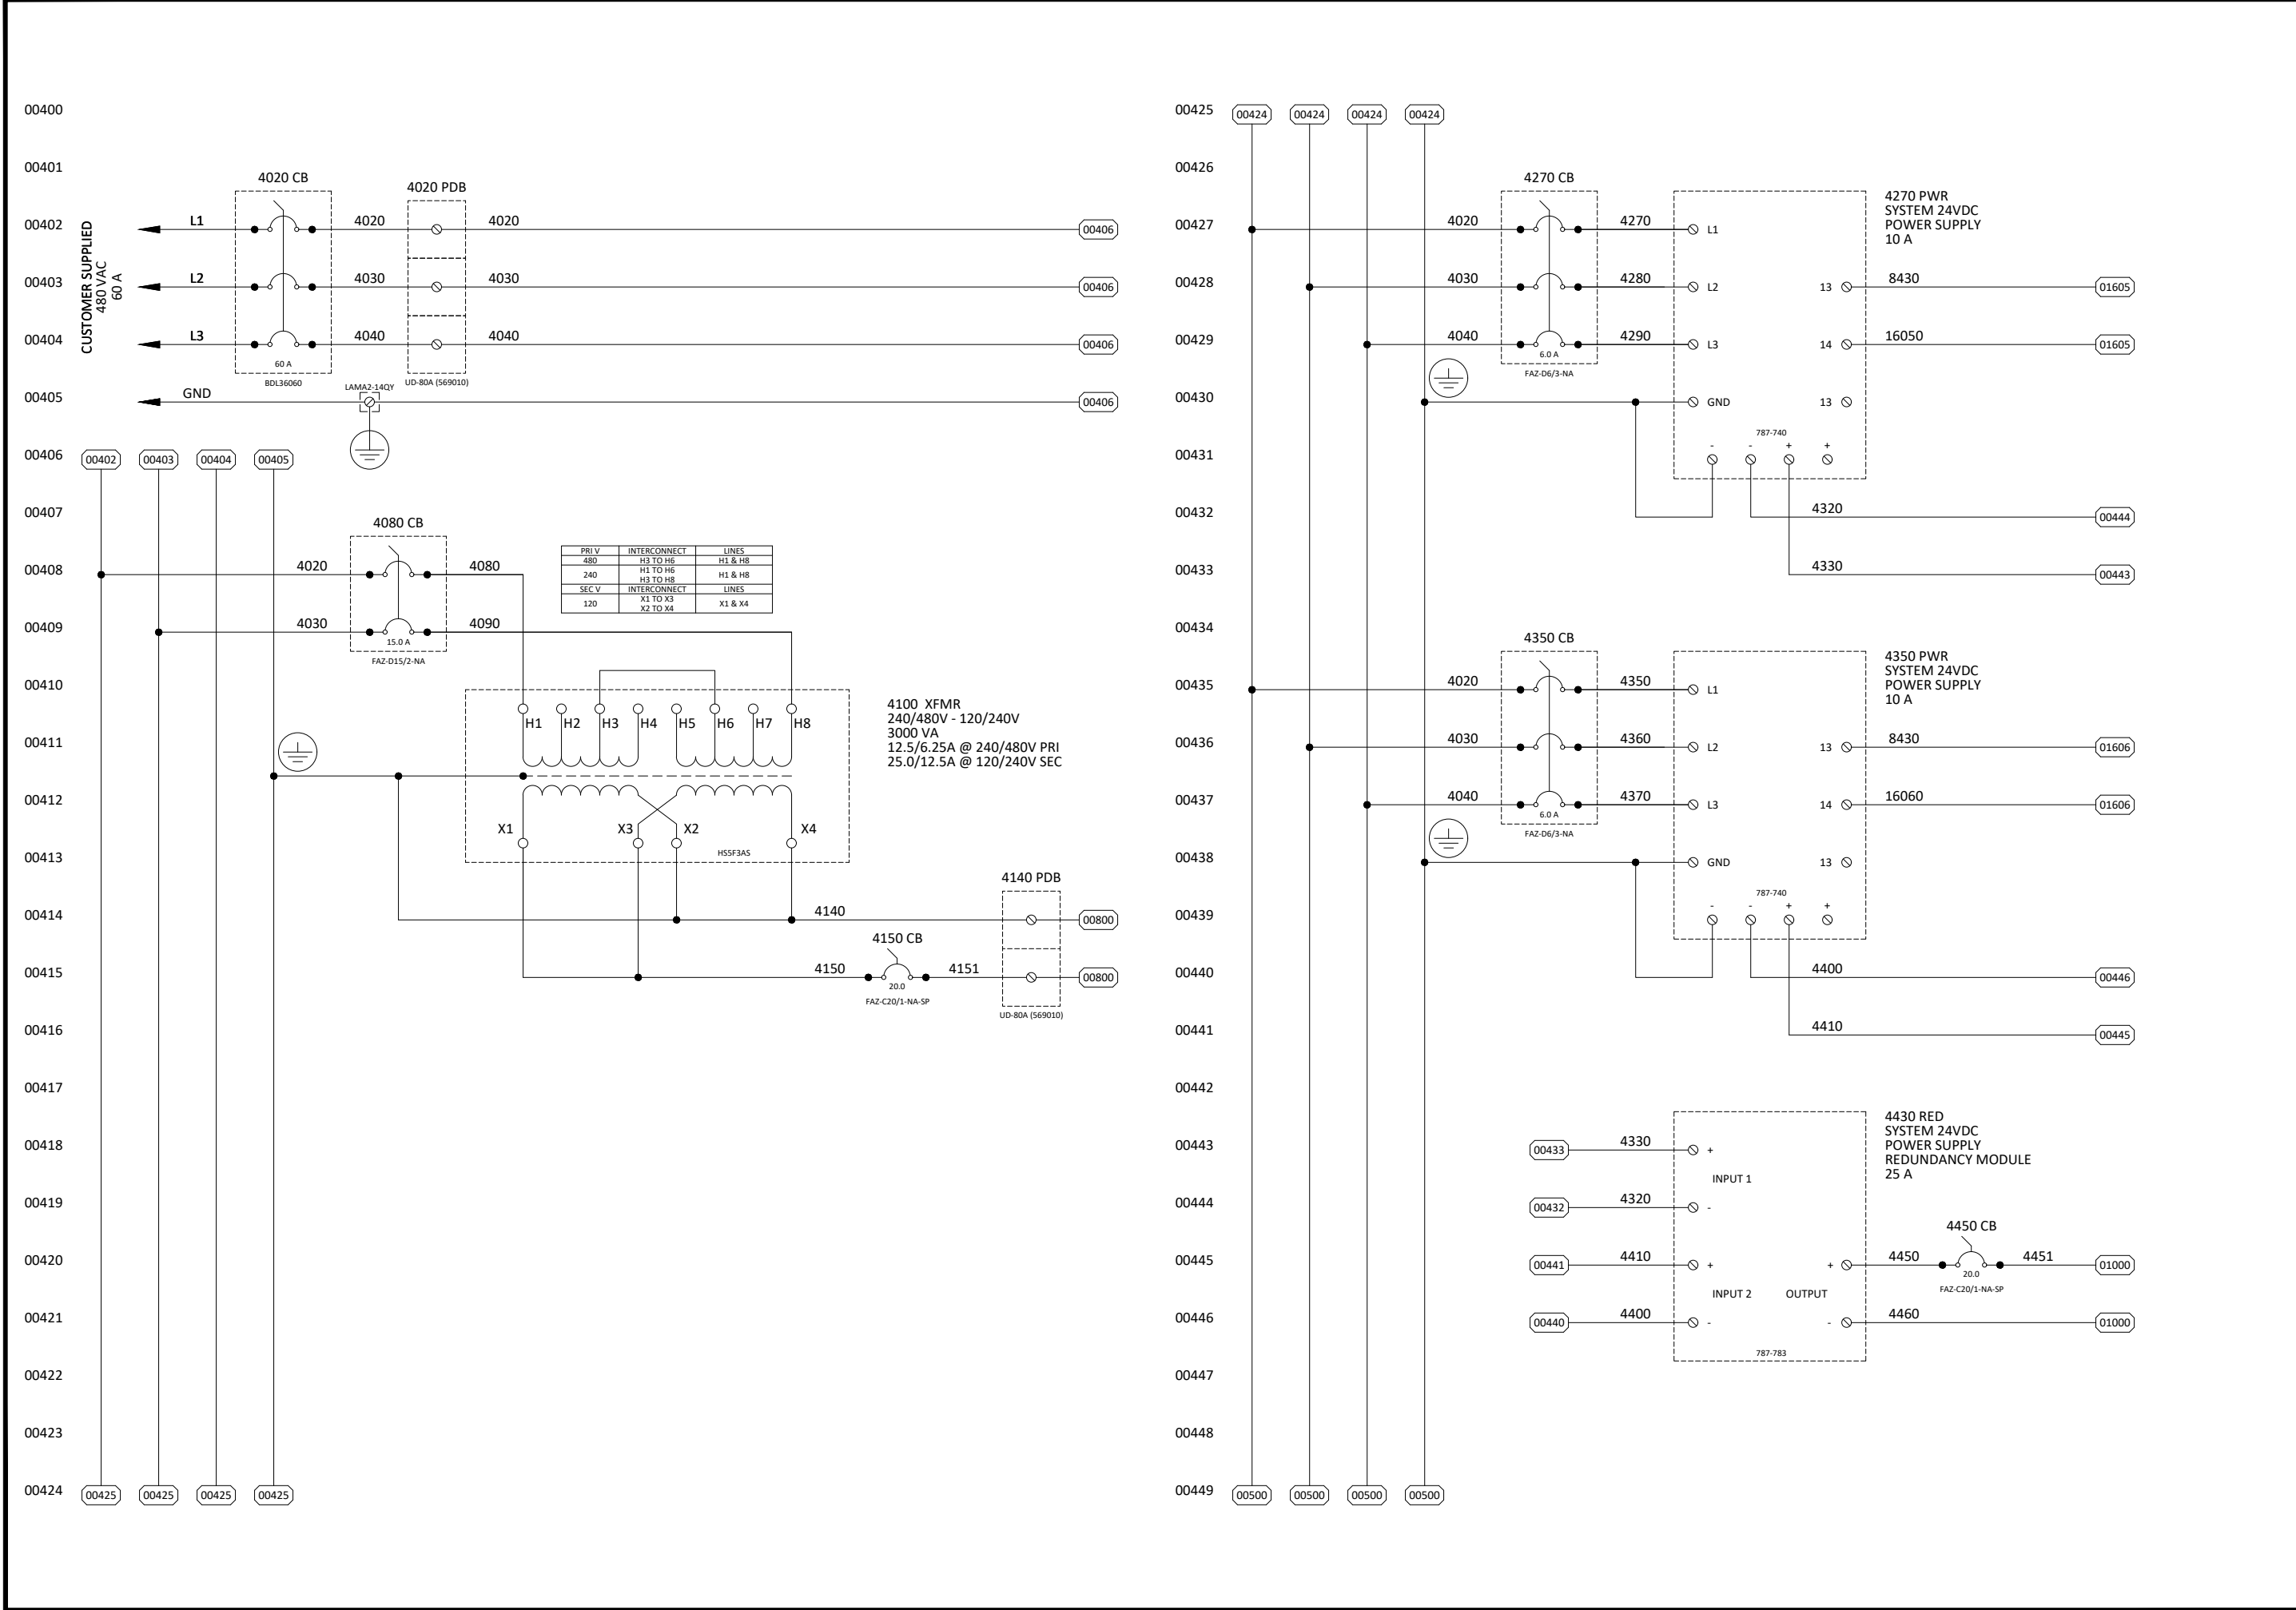

This material is the property of the Dilling Group, Inc. No rights are granted to use such material for any other purpose than the furnishing of services & supplies.



UL US LISTED
E340990
E347820

Dilling
GROUP, INC.
INDUSTRIAL PROCESS GROUP DIVISION
1115 EXECUTIVE DRIVE, WARSAW, IN 46580
574.267.0335
www.dillinggroup.com



REVISIONS:			
REV	BY	DATE	DESCRIPTION
00	BAJ	2021-03-03	RELEASE FOR CONST.
01	BAJ	2021-04-21	AS BUILT

DATE: 2021-02-18	DESIGNED BY: BA JOHNSON
DRAWN BY: BA JOHNSON	REVIEWED BY: JL ARNOLD


UL 508A DESIGN: NO
UL 698A DESIGN: NO
DILLING GROUP PROJECT NUMBER:
D215218

CUSTOMER PROJECT/PO NUMBER:
CR2101G 27289

WAYNE FARMS, UNION AL
REFRIGERATION CONTROL
SYSTEM EVAPORATOR PANEL

480V AC POWER
DISTRIBUTION

2022-10-17 08:29 AM Z:\PIG DATA\IGI PROJECTS\2021\CLOSED\D215218 - REPUBLIC - Wayne Farms Evaporator Control Panel, Union Springs AL\CAO\2260-D Rev-02 - REPUBLIC - Wayne Farms Evaporator Control Panel, Union Springs AL - Job D215218 - 2022-09-07.dwg

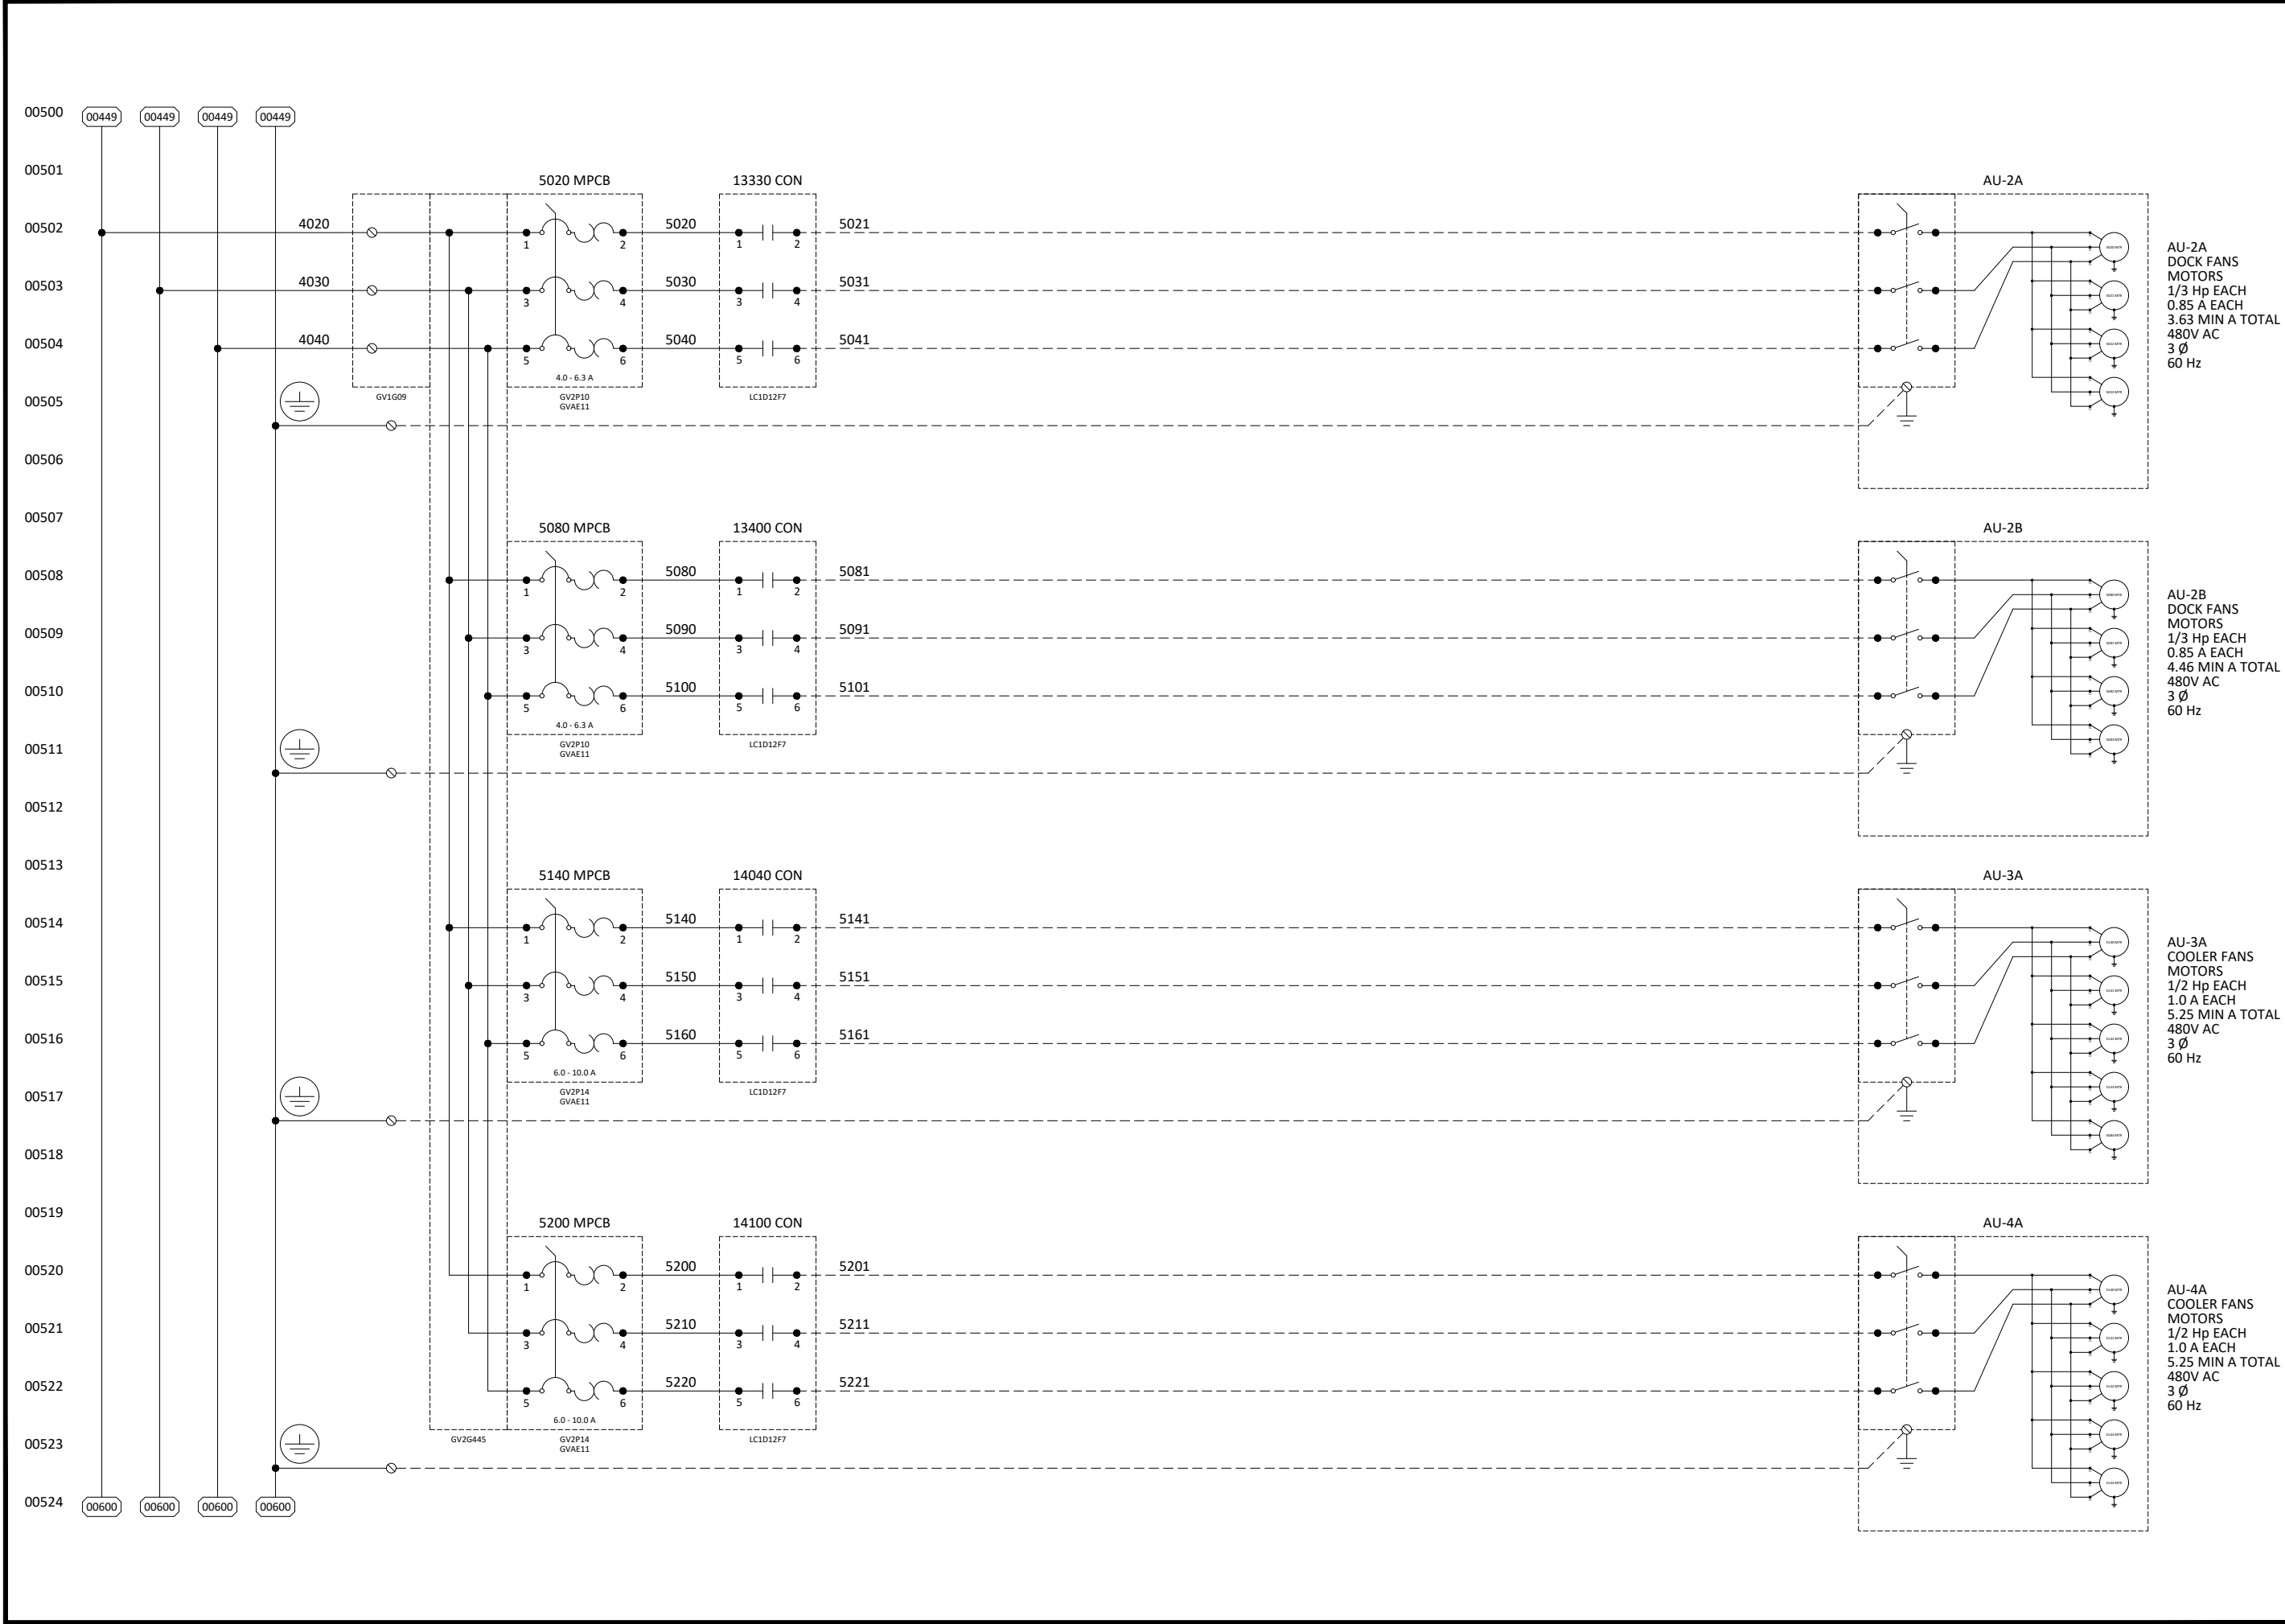

AU-2A
DOCK FANS
MOTORS
1/3 Hp EACH
0.85 A EACH
3.63 MIN A TOTAL
480V AC
3 Ø
60 Hz

AU-2B
DOCK FANS
MOTORS
1/3 Hp EACH
0.85 A EACH
4.46 MIN A TOTAL
480V AC
3 Ø
60 Hz

AU-3A
COOLER FANS
MOTORS
1/2 Hp EACH
1.0 A EACH
5.25 MIN A TOTAL
480V AC
3 Ø
60 Hz

AU-4A
COOLER FANS
MOTORS
1/2 Hp EACH
1.0 A EACH
5.25 MIN A TOTAL
480V AC
3 Ø
60 Hz

This material is the property of the Dilling Group, Inc. No rights are granted to use such material for any other purpose than the furnishing of services & supplies.



UL

US LISTED

E340990

E347820

Dilling

GROUP, INC.

INDUSTRIAL PROCESS GROUP DIVISION

1115 EXECUTIVE DRIVE, WARSAW, IN 46580

574.267.0335

www.dillinggroup.com

COMFORT

SYSTEMS

USA

REVISIONS:			
REV	BY	DATE	DESCRIPTION
00	BAJ	2021-03-03	RELEASE FOR CONST.
01	BAJ	2021-04-21	AS BUILT
DATE:		DESIGNED BY:	
2021-02-18		BA JOHNSON	
DRAWN BY:		REVIEWED BY:	
BA JOHNSON		JL ARNOLD	
UL 508A DESIGN: NO			
UL 698A DESIGN: NO			
DILLING GROUP PROJECT NUMBER:			
D215218			
CUSTOMER PROJECT/PO NUMBER:			
CR2101G 27289			
WAYNE FARMS, UNION AL			
REFRIGERATION CONTROL			
SYSTEM EVAPORATOR PANEL			
480V AC POWER			
DISTRIBUTION			
DRAWING NUMBER:			
2260-D-005			
© 2021, Dilling Group, Inc.			

2022-10-17 08:29 AM Z:\PIG DATA\IGI PROJECTS\2021\CLOSED\D215218 - REPUBLIC - Wayne Farms Evaporator Control Panel, Union Springs AL\CAO\2260-D Rev.02 - REPUBLIC - Wayne Farms Evaporator Control Panel, Union Springs AL - Job D215218 - 2022-09-07.dwg



WAYNE FARMS



2022-10-17 08:28 AM Z:\PGS DATA\PGI PROJECTS\2021\CLOSED\0715218 - REPUBLIC - Wayne Farms Evaporator Control Panel, Union Springs AL (CAD)\2260-D Rev-02 - REPUBLIC REFRIGERATION - Wayne Farms Evaporator Control Panel, Union Springs AL - Job D215218 - 2022-09-07.dwg

[illegible]

DATE: 2021-02-18	DESIGNED BY: BA JOHNSON
DRAWN BY: BA JOHNSON	REVIEWED BY: JL ARNOLD

CUSTOMER PROJECT/PO NUMBER:
CR2101G 27289

120V AC POWER DISTRIBUTION

© 2021, Dilling Group, Inc.

This material is the property of the Dilling Group, Inc. No rights are granted to use such material for any other purpose than the furnishing of services & supplies.


[illegible]

120V AC POWER DISTRIBUTION


DRAWING NUMBER:
2260-D-009

© 2021, Dilling Group, Inc.

2022-10-17 08:28 AM Z:\IPG DATA\IGI PROJECTS\2021\CI\JOSEPH\20215218 - REPIRLC - Wayne Farms Evaporator Control Panel - Union Springs AL - Job D215218 - 2022-09-07.dwg

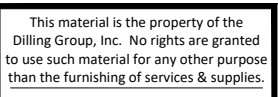

2022-10-17 08:28 AM Z:\PGS DATA\PGI PROJECTS\2021\CLOSED\0715218 - REPUBLIC - Wayne Farms Evaporator Control Panel, Union Springs AL (CAD)\2260-D Rev-02 - REPUBLIC REFRIGERATION - Wayne Farms Evaporator Control Panel, Union Springs AL - Job D215218 - 2022-09-07.dwg

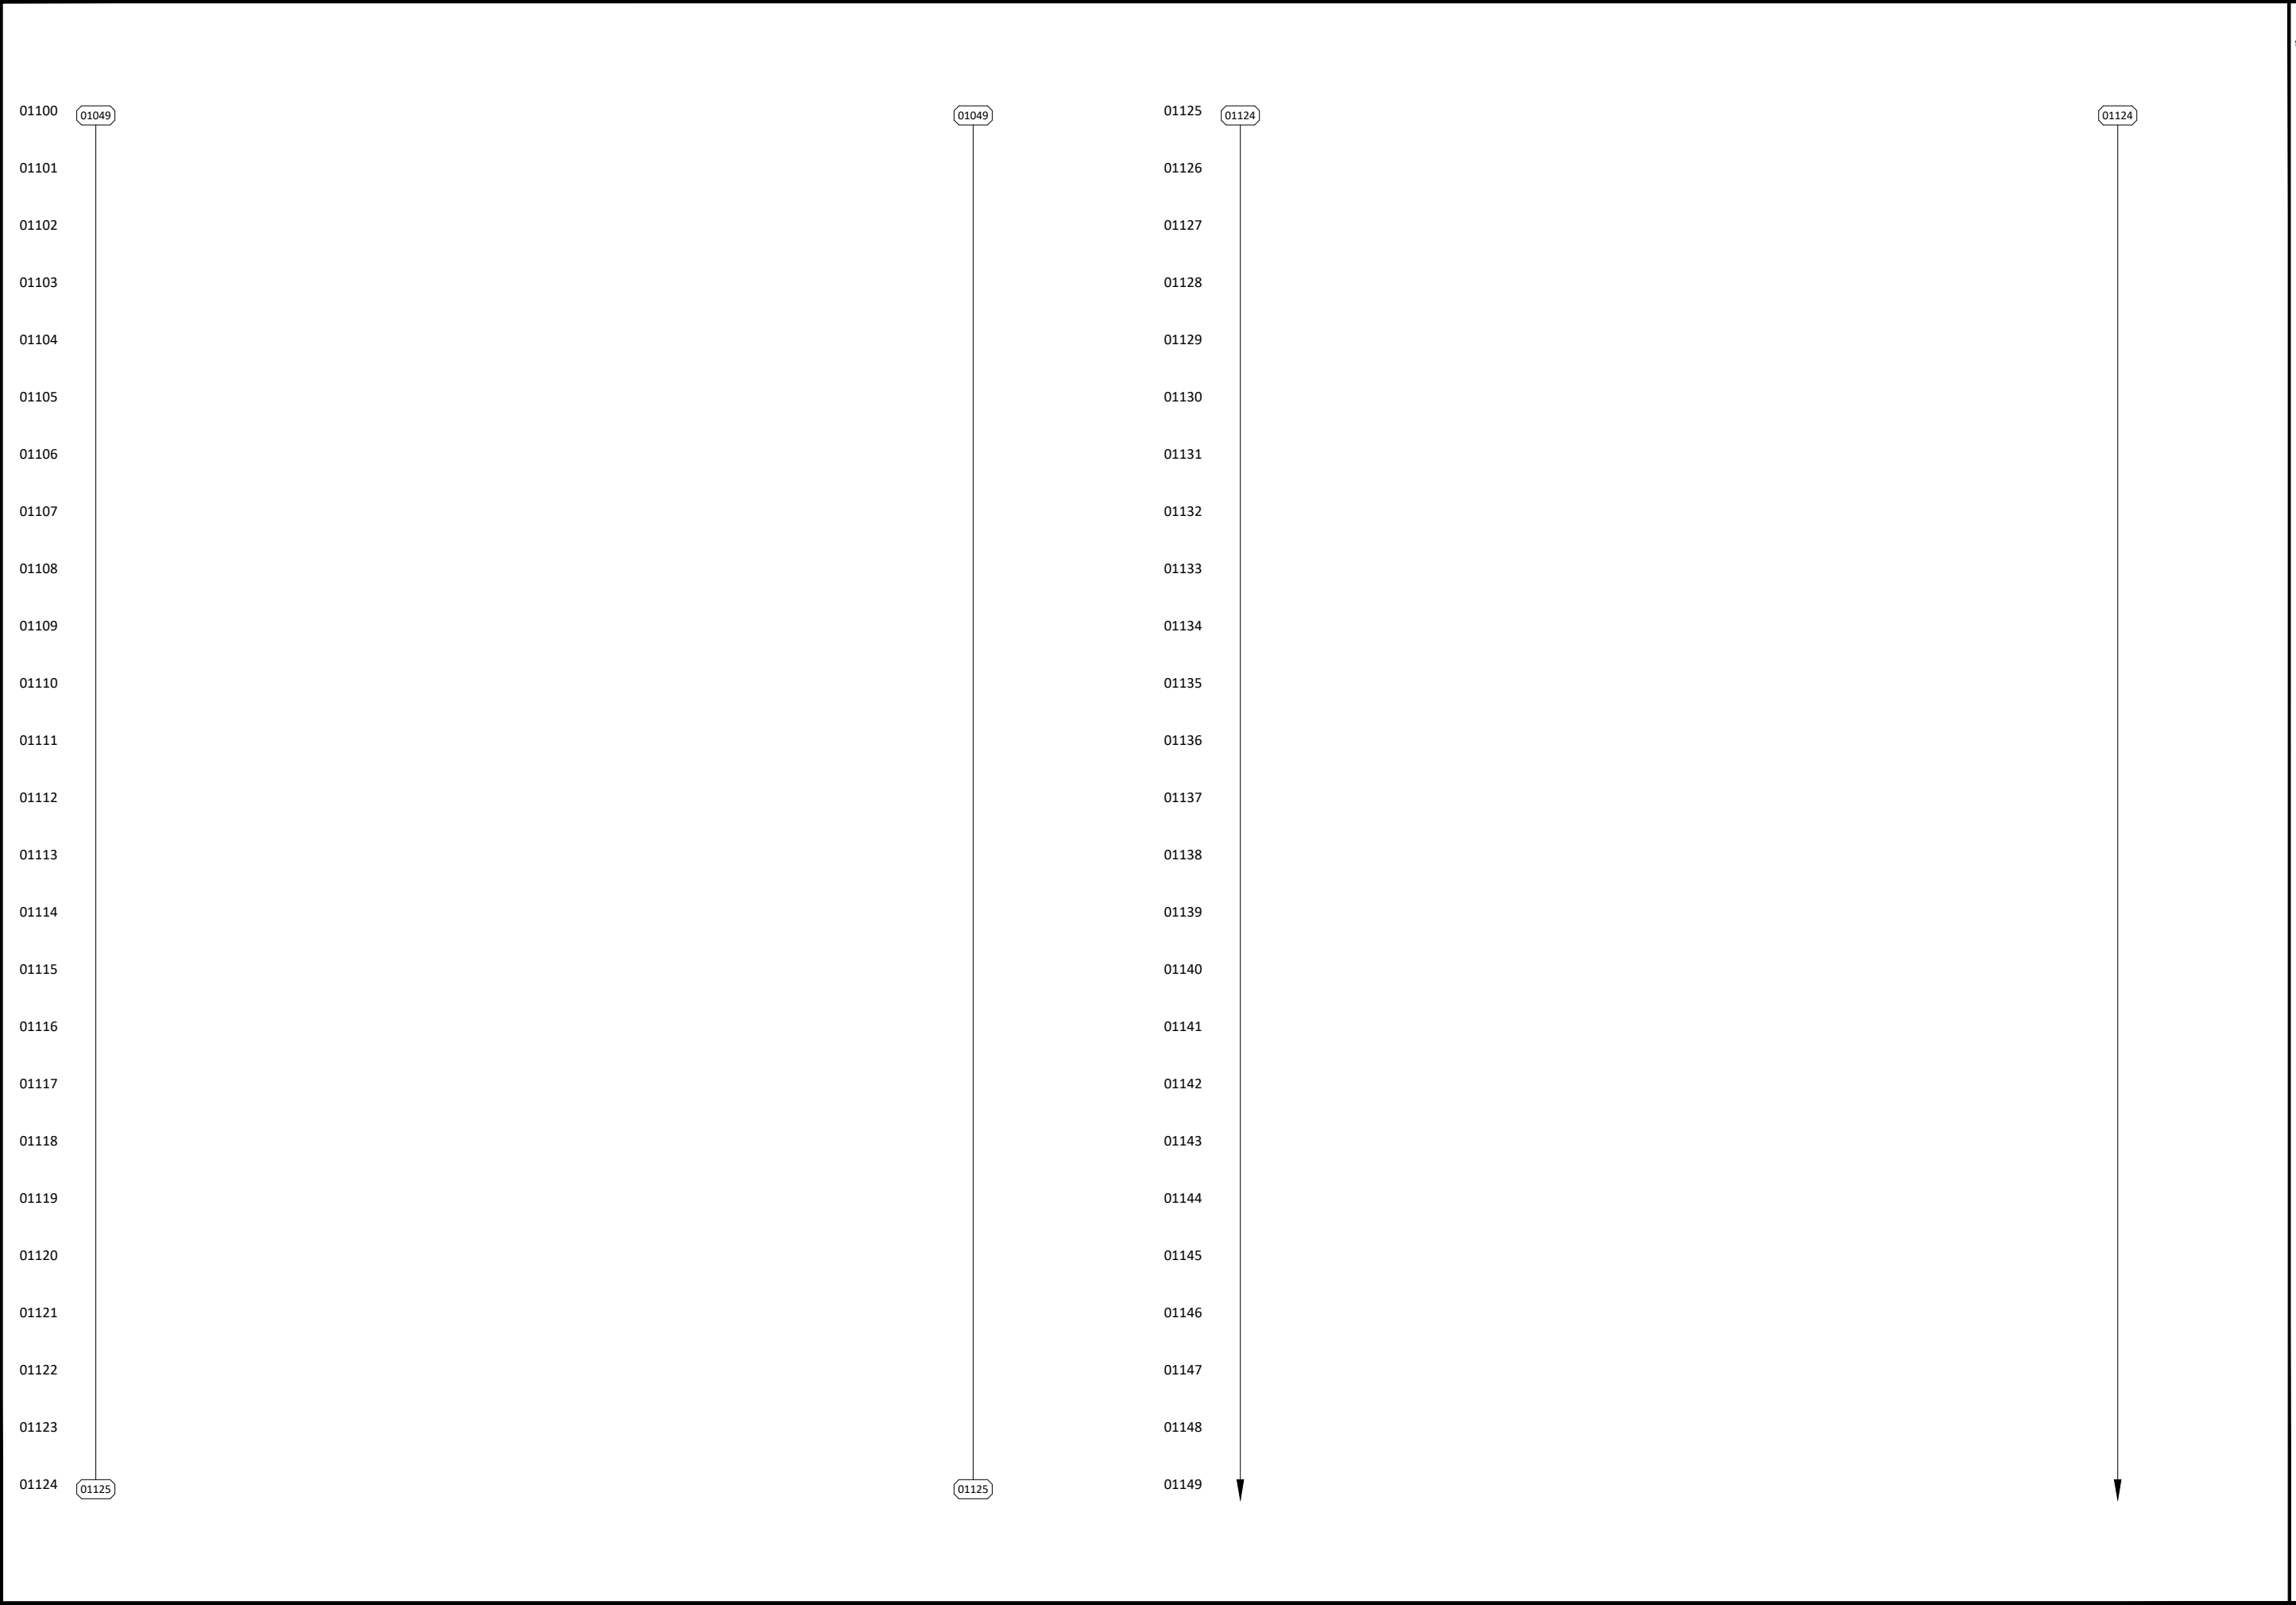

This material is the property of the Dilling Group, Inc. No rights are granted to use such material for any other purpose than the furnishing of services & supplies.

WAYNE FARMS
Republic Refrigeration, Inc.

DillingTM
GROUP, INC.
INDUSTRIAL PROCESS GROUP DIVISION
1135 EXECUTIVE DRIVE, WARSAW, IN 46580
www.dillinggroup.com



COMFORT SYSTEMS USA

REVISIONS:			
REV	BY	DATE	DESCRIPTION
00	BAJ	2021-03-03	RELEASE FOR CONST.
01	BAJ	2021-04-21	AS BUILT
DATE:		DESIGNED BY:	
2021-02-18		BA JOHNSON	
DRAWN BY:		REVIEWED BY:	
BA JOHNSON		JL ARNOLD	
UL 508A DESIGN: NO			
UL 698A DESIGN: NO			
DILLING GROUP PROJECT NUMBER:			
D215218			
CUSTOMER PROJECT/PO NUMBER:			
CR2101G 27289			
WAYNE FARMS, UNION AL REFRIGERATION CONTROL SYSTEM EVAPORATOR PANEL			
24V DC POWER DISTRIBUTION			

DRAWING NUMBER:
2260-D-011




© 2021, Dilling Group, Inc.

2022-10-17 08:28AM Z:\IPG DATA\IGI PROJECTS\2021\CLOSED\D215218 - REPU.BLC - Wayne Farms Evaporator Control Panel, Union Springs AL (C40)\2260-D Rev.02 - REPU.BLC - Wayne Farms Evaporator Control Panel, Union Springs AL - Job D215218 - 2022-09-07.dwg

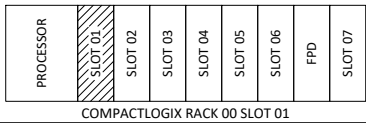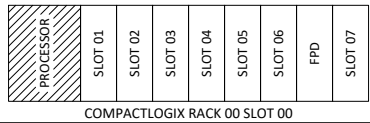

REVISONS:			
REV	BY	DATE	DESCRIPTION
00	BAJ	2021-03-03	RELEASE FOR CONST.
01	BAJ	2021-04-21	AS BUILT
DATE:		DESIGNED BY:	
2021-02-18		BA JOHNSON	
DRAWN BY:		REVIEWED BY:	
BA JOHNSON		JL ARNOLD	
UL 508A DESIGN: NO			
UL 698A DESIGN: NO			
DILLING GROUP PROJECT NUMBER: D215218			
CUSTOMER PROJECT/PO NUMBER: CR2101G 27289			
WAYNE FARMS, UNION AL REFRIGERATION CONTROL SYSTEM EVAPORATOR PANEL			
COMPACT LOGIX RACK 00 SLOTS 00 AND 01			
DRAWING NUMBER: 2260-D-012			
© 2021, Dilling Group, Inc.			

2022-10-17	08:29 AM	Z:\IPC DATA\DCI PROJECTS\2021\GJOSEPH\0215218 - REPIRI IC - Wayne Farms Evaporator Control Panel	Union Springs AL CAD 2760-D Rev-02 - REPIRI IC REFRIGERATION - Wayne Farms Evaporator Control Panel	Union Springs AL - 2022-09-07 dave
------------	----------	--	---	------------------------------------

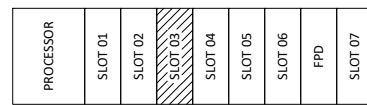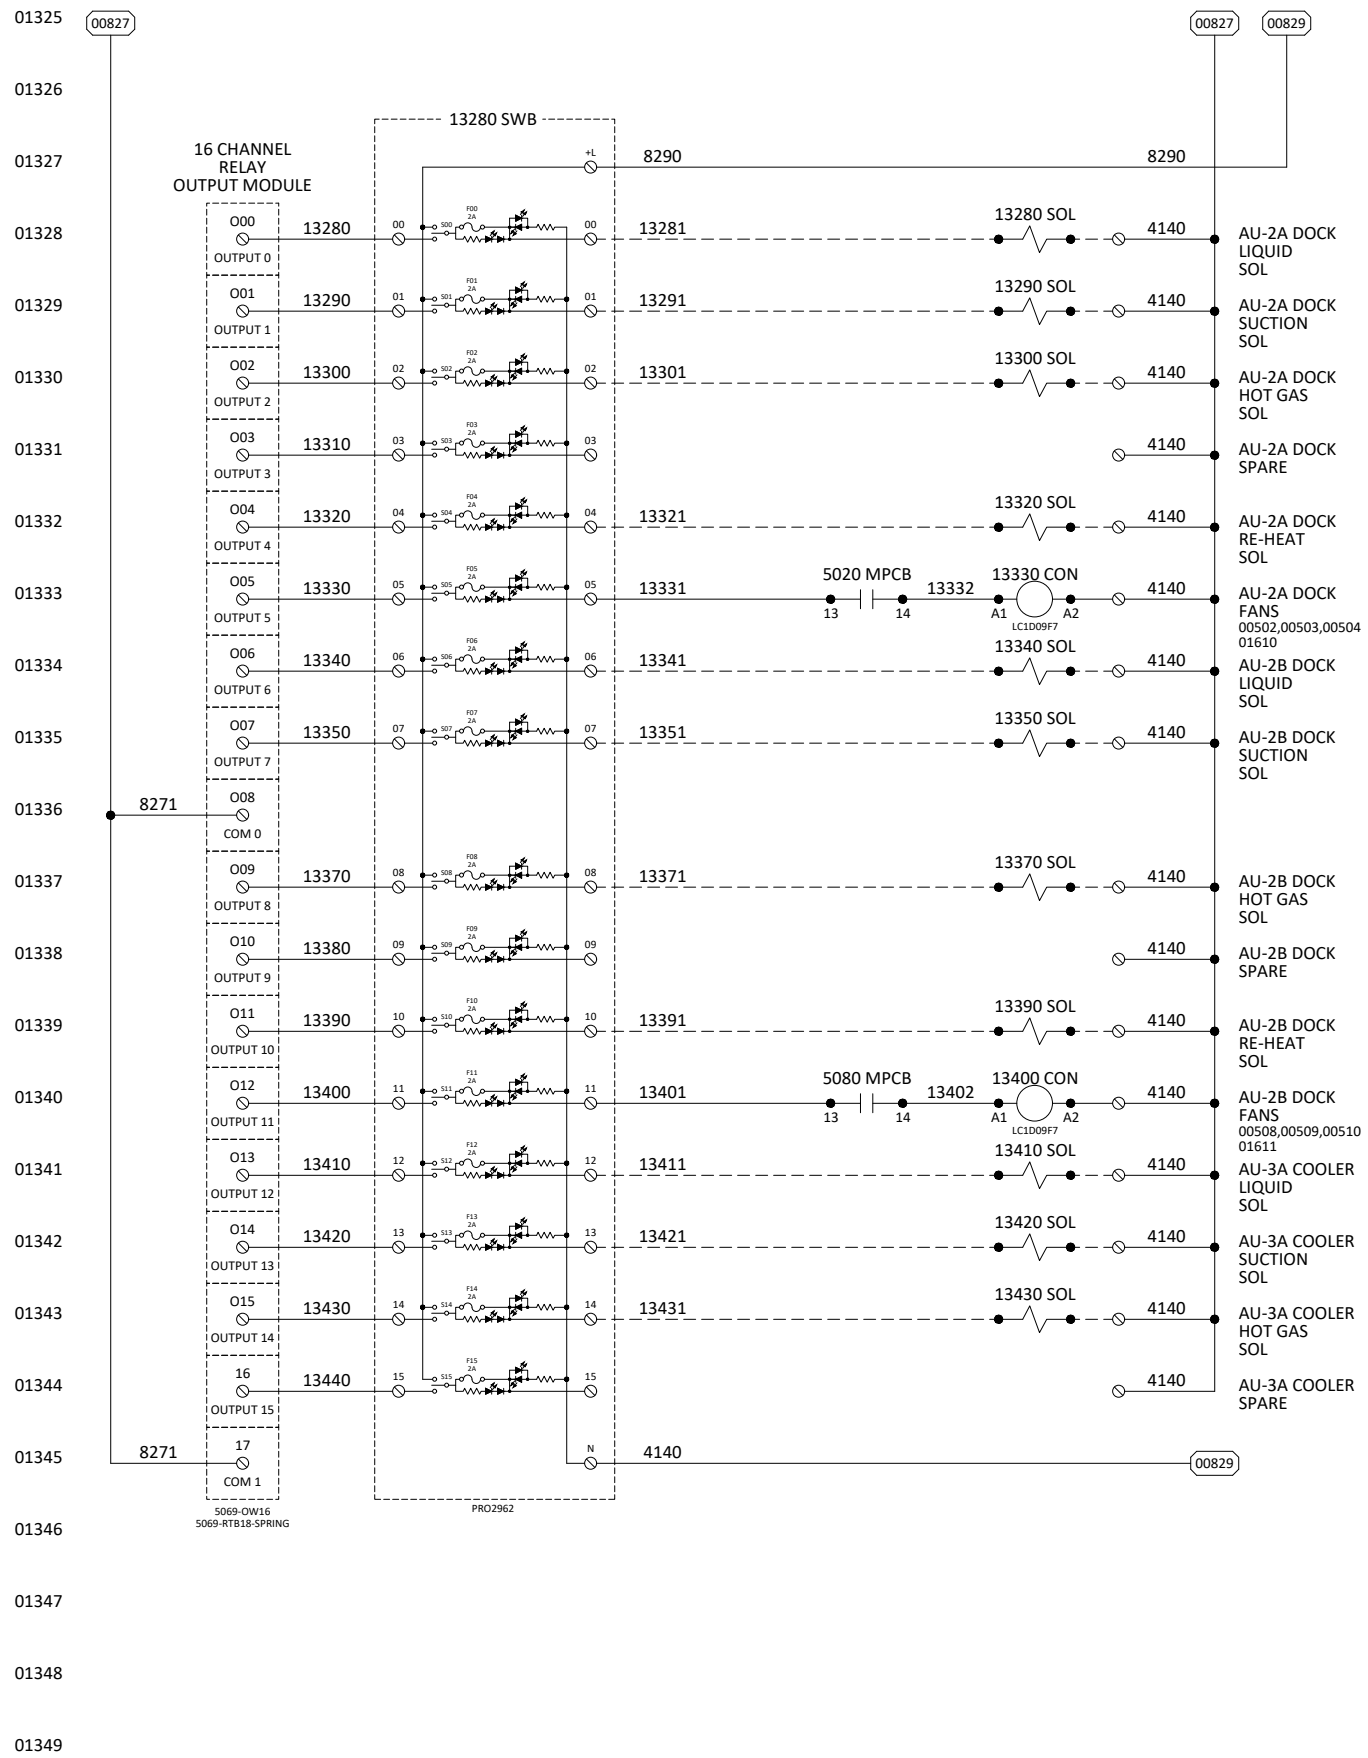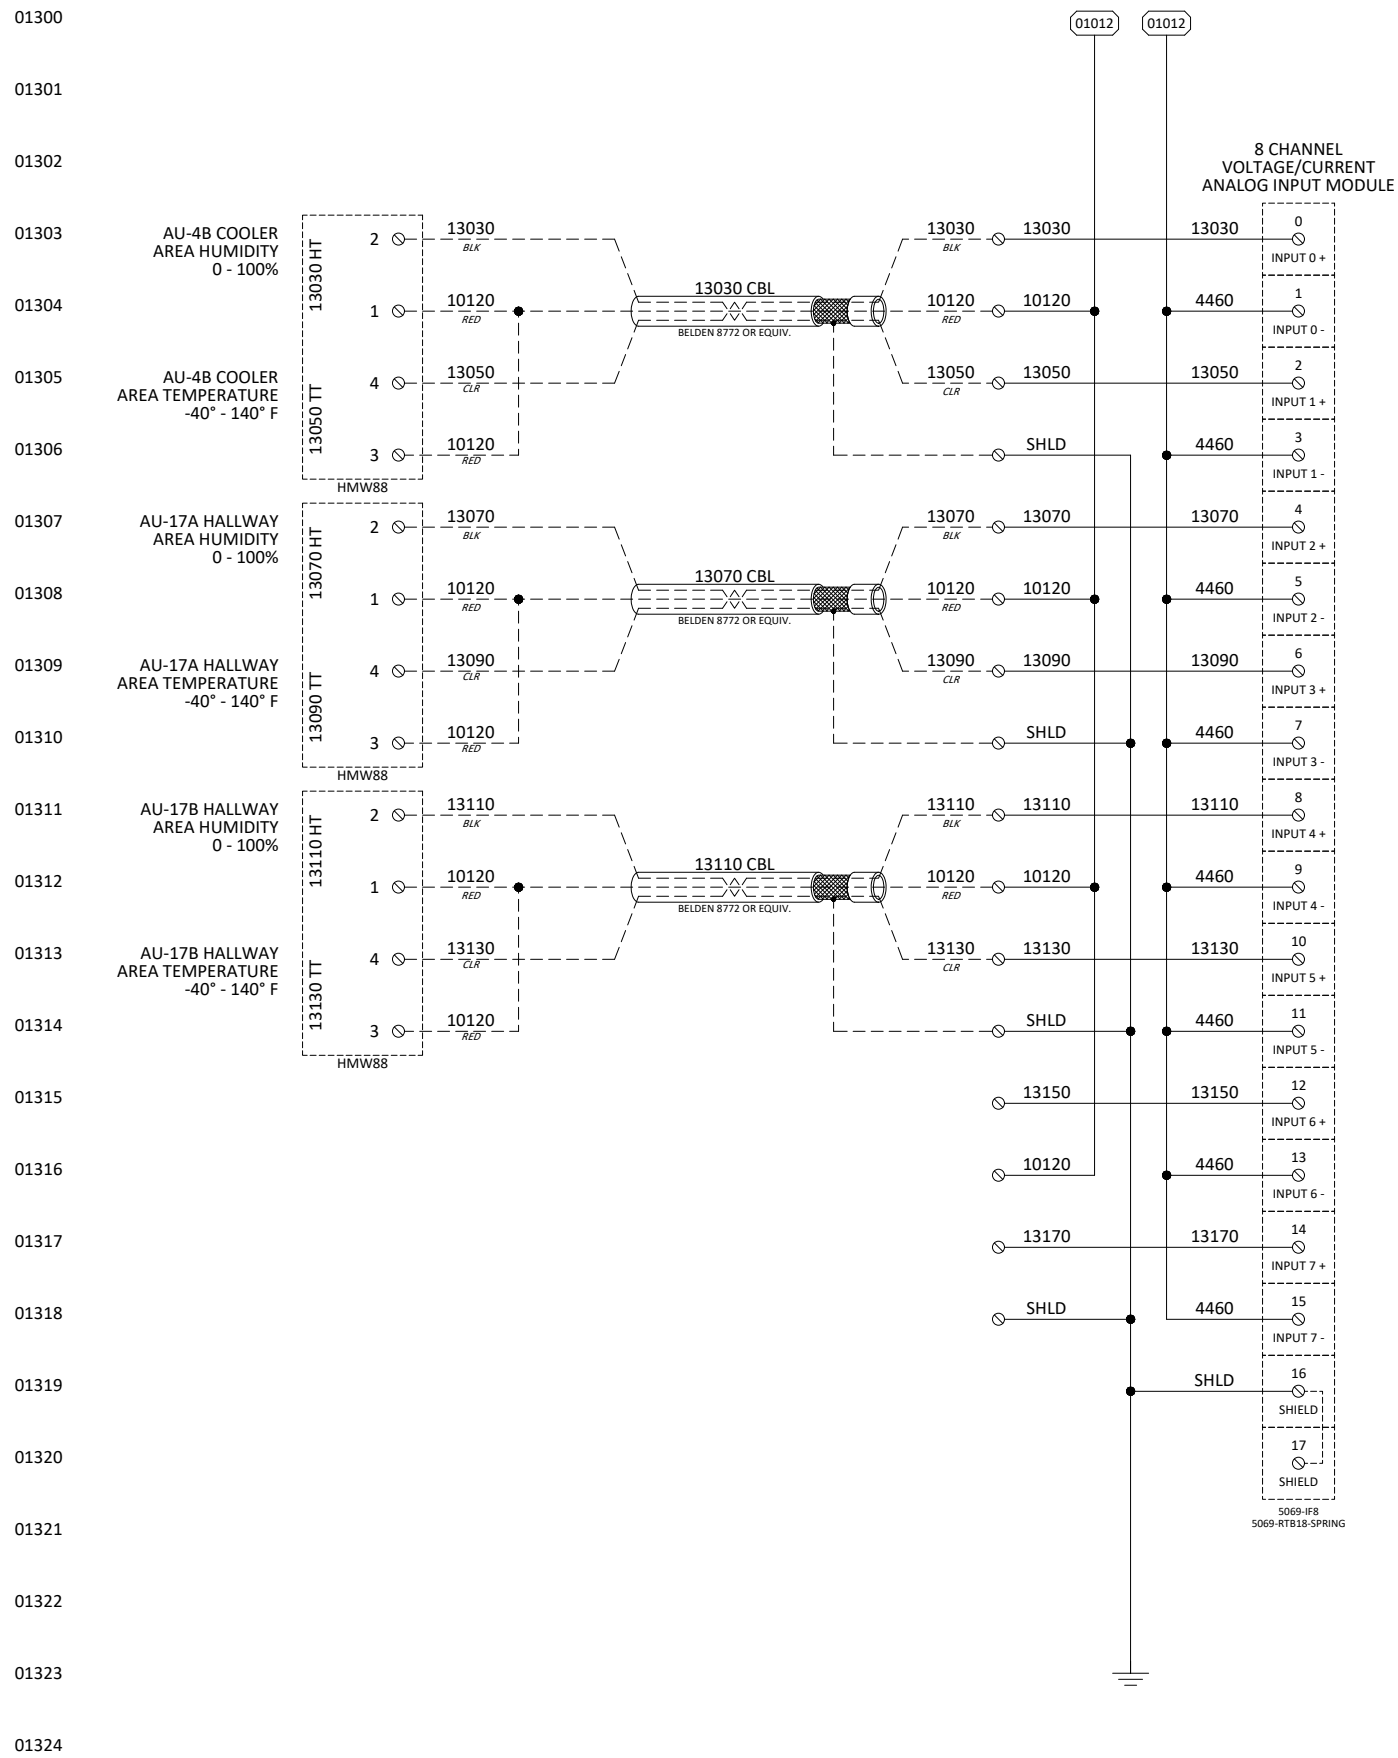

This material is the property of the Dilling Group, Inc. No rights are granted to use such material for any other purpose than the furnishing of services & supplies.



REVISONS:			
REV	BY	DATE	DESCRIPTION
00	BAJ	2021-03-03	RELEASE FOR CONST.
01	BAJ	2021-04-21	AS BUILT
DATE:		DESIGNED BY:	
2021-02-18		BA JOHNSON	
DRAWN BY:		REVIEWED BY:	
BA JOHNSON		JL ARNOLD	
UL 508A DESIGN: NO			
UL 698A DESIGN: NO			
<u>DILLING GROUP PROJECT NUMBER:</u>			
D215218			
<u>CUSTOMER PROJECT/PO NUMBER:</u>			
CR2101G 27289			
WAYNE FARMS, UNION AL			
REFRIGERATION CONTROL			
SYSTEM EVAPORATOR PANEL			
COMPACT LOGIX			
RACK 00			
SLOTS 02 AND 03			
<u>DRAWING NUMBER:</u>			
2260-D-013			
© 2021, Dilling Group, Inc.			

2022-10-17 08:28 AM Z:\PGC DATA\DCI PROJECTS\2021\CI OF SE\18 - REPIBILIC REFRIGERATION - Wayne Farms Evaporator Control Panel Union Springs AL - Job D215218 - 2022-09-07.dwg






WAYNE FARMS®

DillingTM
GROUP, INC.
INDUSTRIAL PROCESS GROUP DIVISION
1135 EXECUTIVE DRIVE, WARGAWA IN 46580
574.267.0135
www.dillinggroup.com

[illegible]

DRAWING NUMBER:
2260-D-014

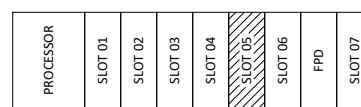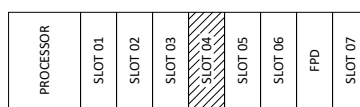

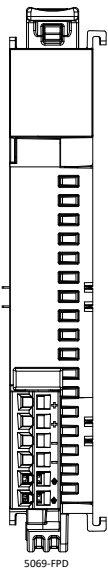

PROCESSOR							
	SLOT 01						
	SLOT 02						
	SLOT 03						
	SLOT 04						
	SLOT 05						
	SLOT 06						
	FPD						
	SLOT 07						

COMPACTLOGIX RACK 00



Wayne Farms
Republic Refrigeration, Inc.

UL **US LISTED**
E340990
E347820

Dilling™
GROUP, INC.
INDUSTRIAL PROCESS GROUP DIVISION
1135 EXECUTIVE DRIVE, WARSAW, IN 46580
574.267.0135
www.dillinggroup.com



REVISIONS:			
REV	BY	DATE	DESCRIPTION
00	BAJ	2021-03-03	RELEASE FOR CONST.
01	BAJ	2021-04-21	AS BUILT

DATE: 2021-02-18	DESIGNED BY: BA JOHNSON
DRAWN BY: BA JOHNSON	REVIEWED BY: JL ARNOLD

UL 508A DESIGN: NO
UL 698A DESIGN: NO

DILLING GROUP PROJECT NUMBER:
D215218

CUSTOMER PROJECT/PO NUMBER:
CR2101G 27289


WAYNE FARMS, UNION AL
REFRIGERATION CONTROL
SYSTEM EVAPORATOR PANEL

COMPACT LOGIX
RACK 00
SLOT 06 AND FDP

DRAWING NUMBER:
2260-D-015

© 2021, Dilling Group, Inc.

2022-10-17 08:28 AM Z:\JPG DATA\DIGI PROJECTS\2021\CLOSED\0215218 - REPUBLIC - Wayne Farms Evaporator Control Panel\Union Springs AL - job D215218 - 2022-09-07.dwg

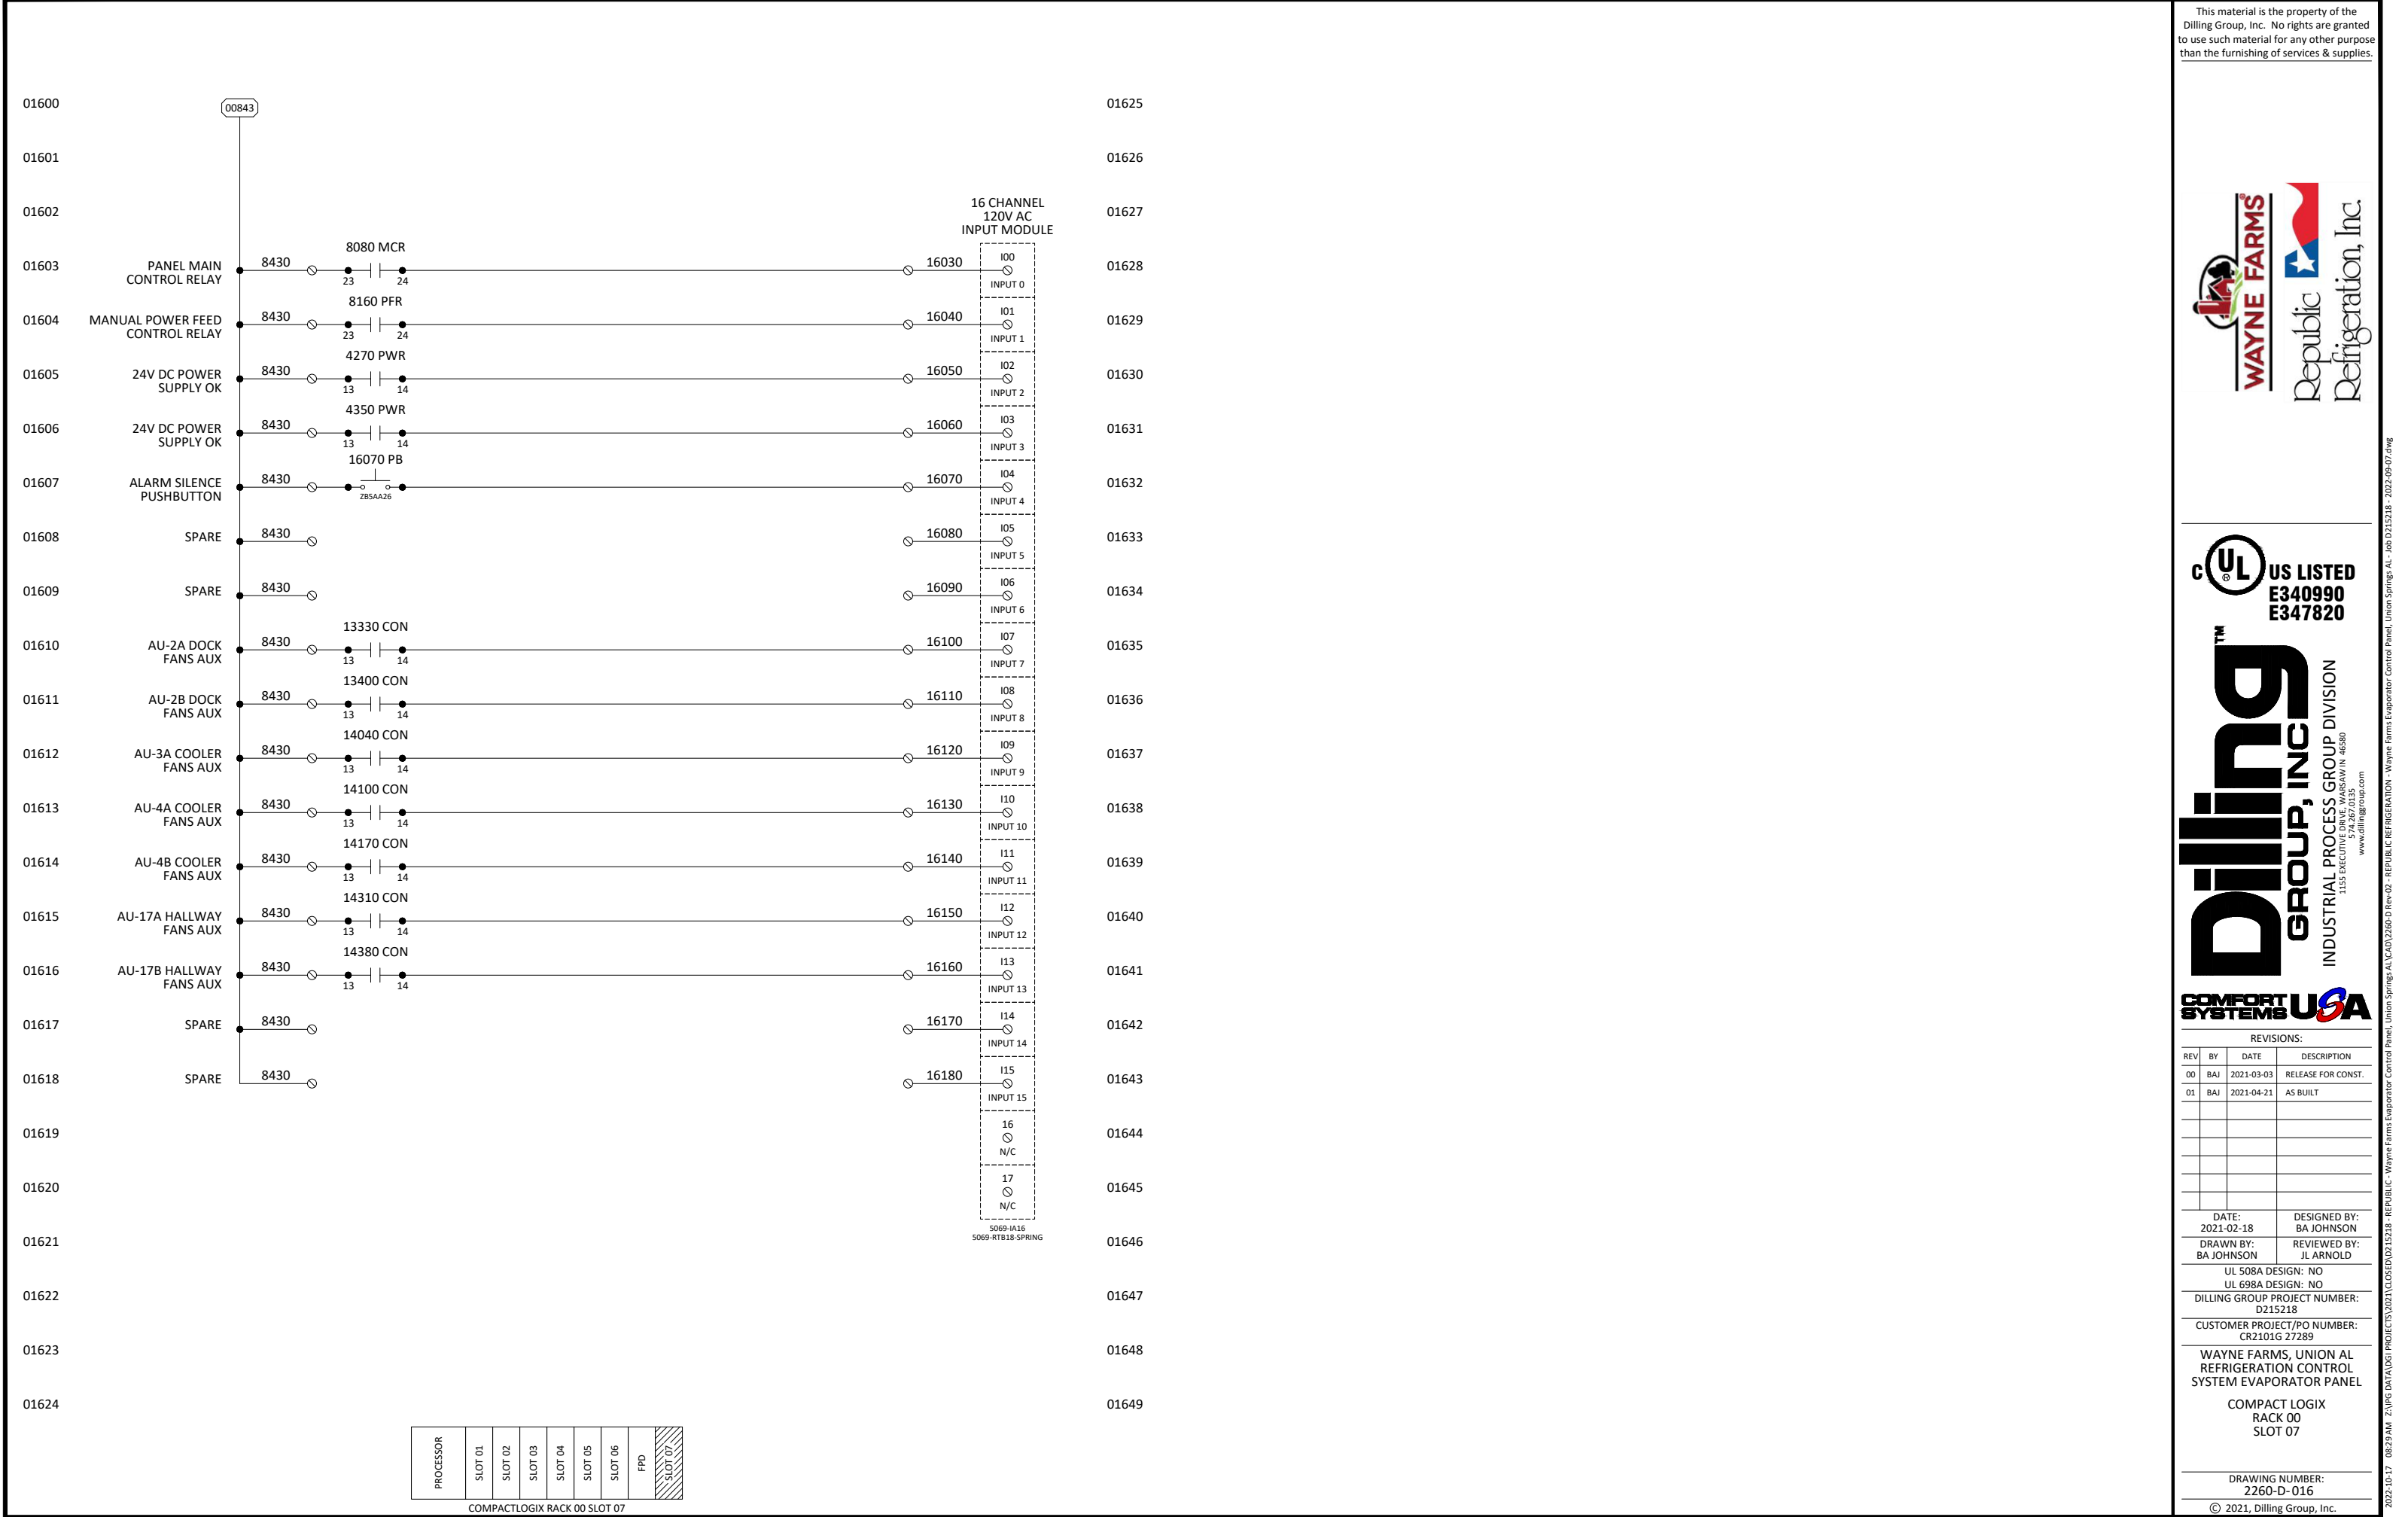

PROCESSOR

SLOT 01

SLOT 02

SLOT 03

SLOT 04

SLOT 05

SLOT 06

FPD

SLOT 07

COMPACTLOGIX RACK 00 SLOT 07

This material is the property of the Dilling Group, Inc. No rights are granted to use such material for any other purpose than the furnishing of services & supplies.



REVISIONS:			
REV	BY	DATE	DESCRIPTION
00	BAJ	2021-03-03	RELEASE FOR CONST.
01	BAJ	2021-04-21	AS BUILT

DATE: 2021-02-18	DESIGNED BY: BA JOHNSON
DRAWN BY: BA JOHNSON	REVIEWED BY: JL ARNOLD

UL 508A DESIGN: NO
UL 698A DESIGN: NO

DILLING GROUP PROJECT NUMBER:
D215218

CUSTOMER PROJECT/PO NUMBER:
CR2101G 27289


WAYNE FARMS, UNION AL
REFRIGERATION CONTROL
SYSTEM EVAPORATOR PANEL

COMPACT LOGIX
RACK 00
SLOT 07

DRAWING NUMBER:
2260-D-016

© 2021, Dilling Group, Inc.

2022-10-17 08:29 AM Z:\IPG DATA\UGI PROJECTS\2021\CLOSED\D215218 - REPUBLIC - Wayne Farms Evaporator Control Panel.dwg - 2022-09-07.dwg

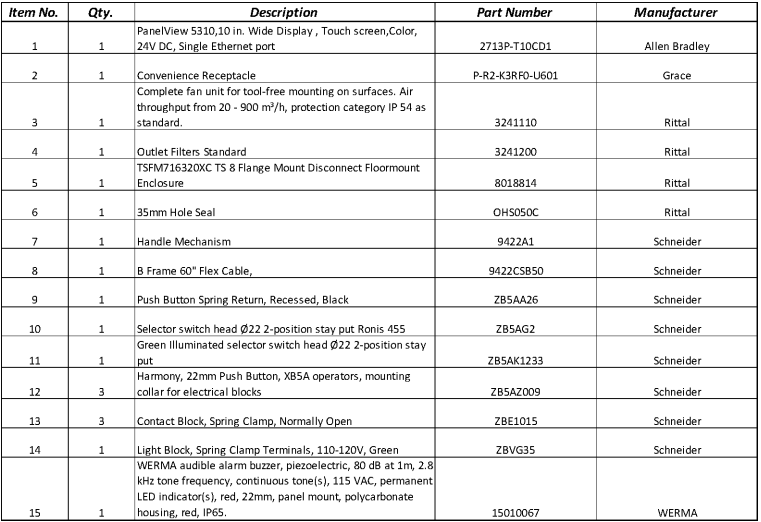

Item No.	Qty.	Description	Part Number	Manufacturer
1	1	PanelView 5310, 10 in. Wide Display , Touch screen,Color, 24V DC, Single Ethernet port	2713P-T10CD1	Allen Bradley
2	1	Convenience Receptacle	P-R2-K3RFO-U601	Grace
3	1	Complete fan unit for tool-free mounting on surfaces. Air throughput from 20 - 900 m³/h, protection category IP 54 as standard.	3241110	Rittal
4	1	Outlet Filters Standard	3241200	Rittal
5	1	TSFM716320XC TS 8 Flange Mount Disconnect Floormount Enclosure	8018814	Rittal
6	1	35mm Hole Seal	OH5050C	Rittal
7	1	Handle Mechanism	942Z41	Schneider
8	1	B Frame 60" Flex Cable,	942ZCSB50	Schneider
9	1	Push Button Spring Return, Recessed, Black	ZB5AA26	Schneider
10	1	Selector switch head Ø22 2-position stay put Ronis 455	ZB5AG2	Schneider
11	1	Green Illuminated selector switch head Ø22 2-position stay put	ZB5AK233	Schneider
12	3	Harmony, 22mm Push Button, XB5A operators, mounting collar for electrical blocks	ZB5AZ209	Schneider
13	3	Contact Block, Spring Clamp, Normally Open	ZBE1015	Schneider
14	1	Light Block, Spring Clamp Terminals, 110-120V, Green	ZBVG35	Schneider
15	1	WERMA audible alarm buzzer, piezoelectric, 80 dB at 1m, 2.8 kHz tone frequency, continuous tone(s), 115 VAC, permanent LED indicator(s), red, 22mm, panel mount, polycarbonate housing, red, IP65.	15010067	WERMA



Wayne Farms
Republic Refrigeration, Inc.



DRAWING NUMBER:
2260-D-019

© 2021, Dilling Group, Inc.