




REFRIGERATION SYSTEM SAFETY CONTROL PANEL WAYNE FARMS UNION SPRINGS, AL

UNI-TEMP REFRIGERATION PROJECT 3807
RELEASE: 05 - AS INSTALLED

DRAWING INDEX:

- RC-1 COVER SHEET/DRAWING INDEX
- RC-2 ENCLOSURE LAYOUT
- RC-3 CONDUIT PLAN
- RC-4 SAFETY CIRCUIT
- RC-5 SAFETY CIRCUIT
- RC-6 VENTILATION INTERLOCK WIRING
- RC-7 AMMONIA MONITORING STATION
- RC-8 AMMONIA MONITORING STATION
- RC-9

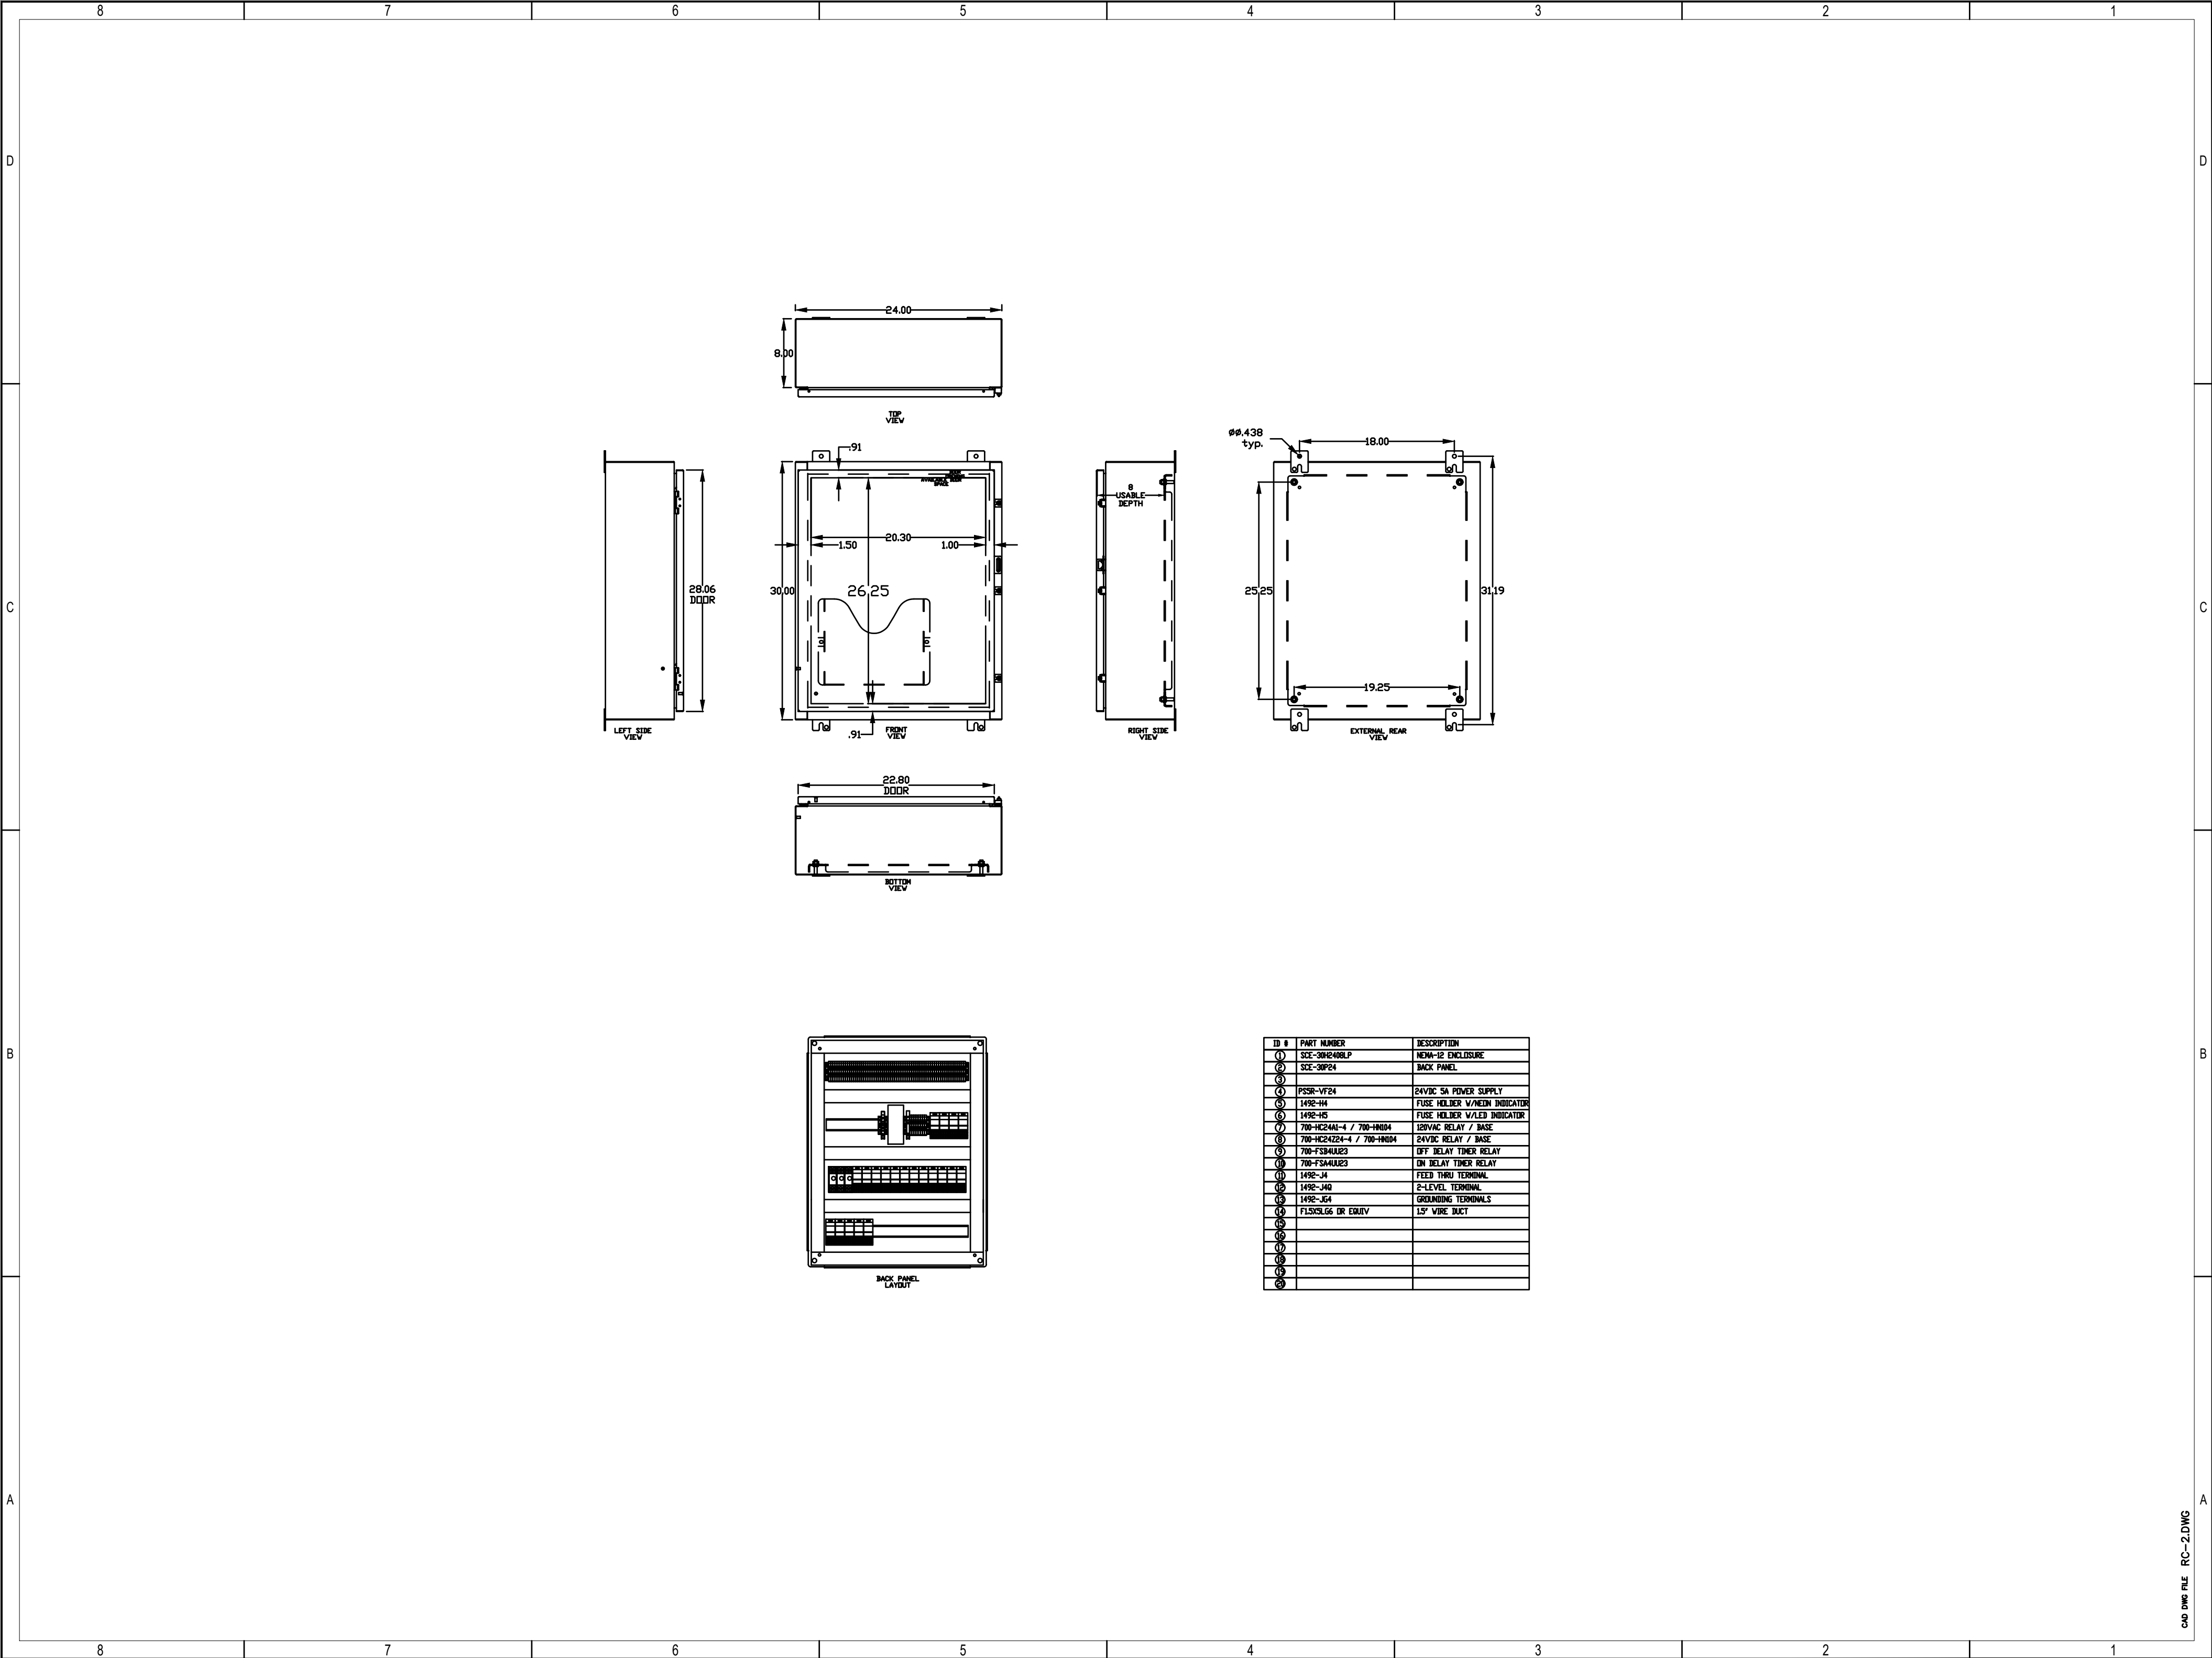

4487 S. Old Peachtree Rd.
Atlanta, Georgia 30327
Phone: 800.227.3517
Fax: 770.241.8894
www.unitemp.com

Uni-Temp
REFRIGERATION, INC.

**WAYNE FARMS**

Client:

Project:

**REFRIGERATION SYSTEM
SAFETY CONTROL PANEL**
WAYNE FARMS
UNION SPRINGS, AL

Rev	Date	By	App'd	Description
1	03/12/19	GG		PRELIMINARY - FOR REVIEW ONLY
2	03/19/19	GG		FOR CONSTRUCTION
3	04/10/19	GG		FOR INSTALLATION
4	08/27/19	GG		CORRECTIONS DURING INSTALLATION
5	10/18/19	GG		AS INSTALLED

THIS DOCUMENT CONTAINING
PROPERTY INFORMATION BELONGING
TO UNI-TEMP REFRIGERATION, INC.
OR ITS AFFILIATED COMPANIES AND
SHALL BE USED ONLY FOR THE
PURPOSE FOR WHICH IT WAS
SUPPLIED. IT SHALL NOT BE COPIED,
REPRODUCED OR OTHERWISE USED,
NOR SUCH INFORMATION BE
FURNISHED IN WHOLE OR IN PART,
TO OTHERS EXCEPT IN ACCORDANCE
WITH THE TERMS OF ANY AGREEMENT
UNDER WHICH IT WAS SUPPLIED OR
WITH PRIOR WRITTEN CONSENT OF
UNI-TEMP REFRIGERATION, INC. AND
SHALL BE RETURNED UPON REQUEST.

Project No.: 3807

Drawn by: G Garrett

Dwg Date: 03/12/19


Prog. Engr.: J Howell

Scale: NONE

Sheet No.: 2 OF 9

Sheet Title: Enclosure Layout

Sheet Name: RC-2

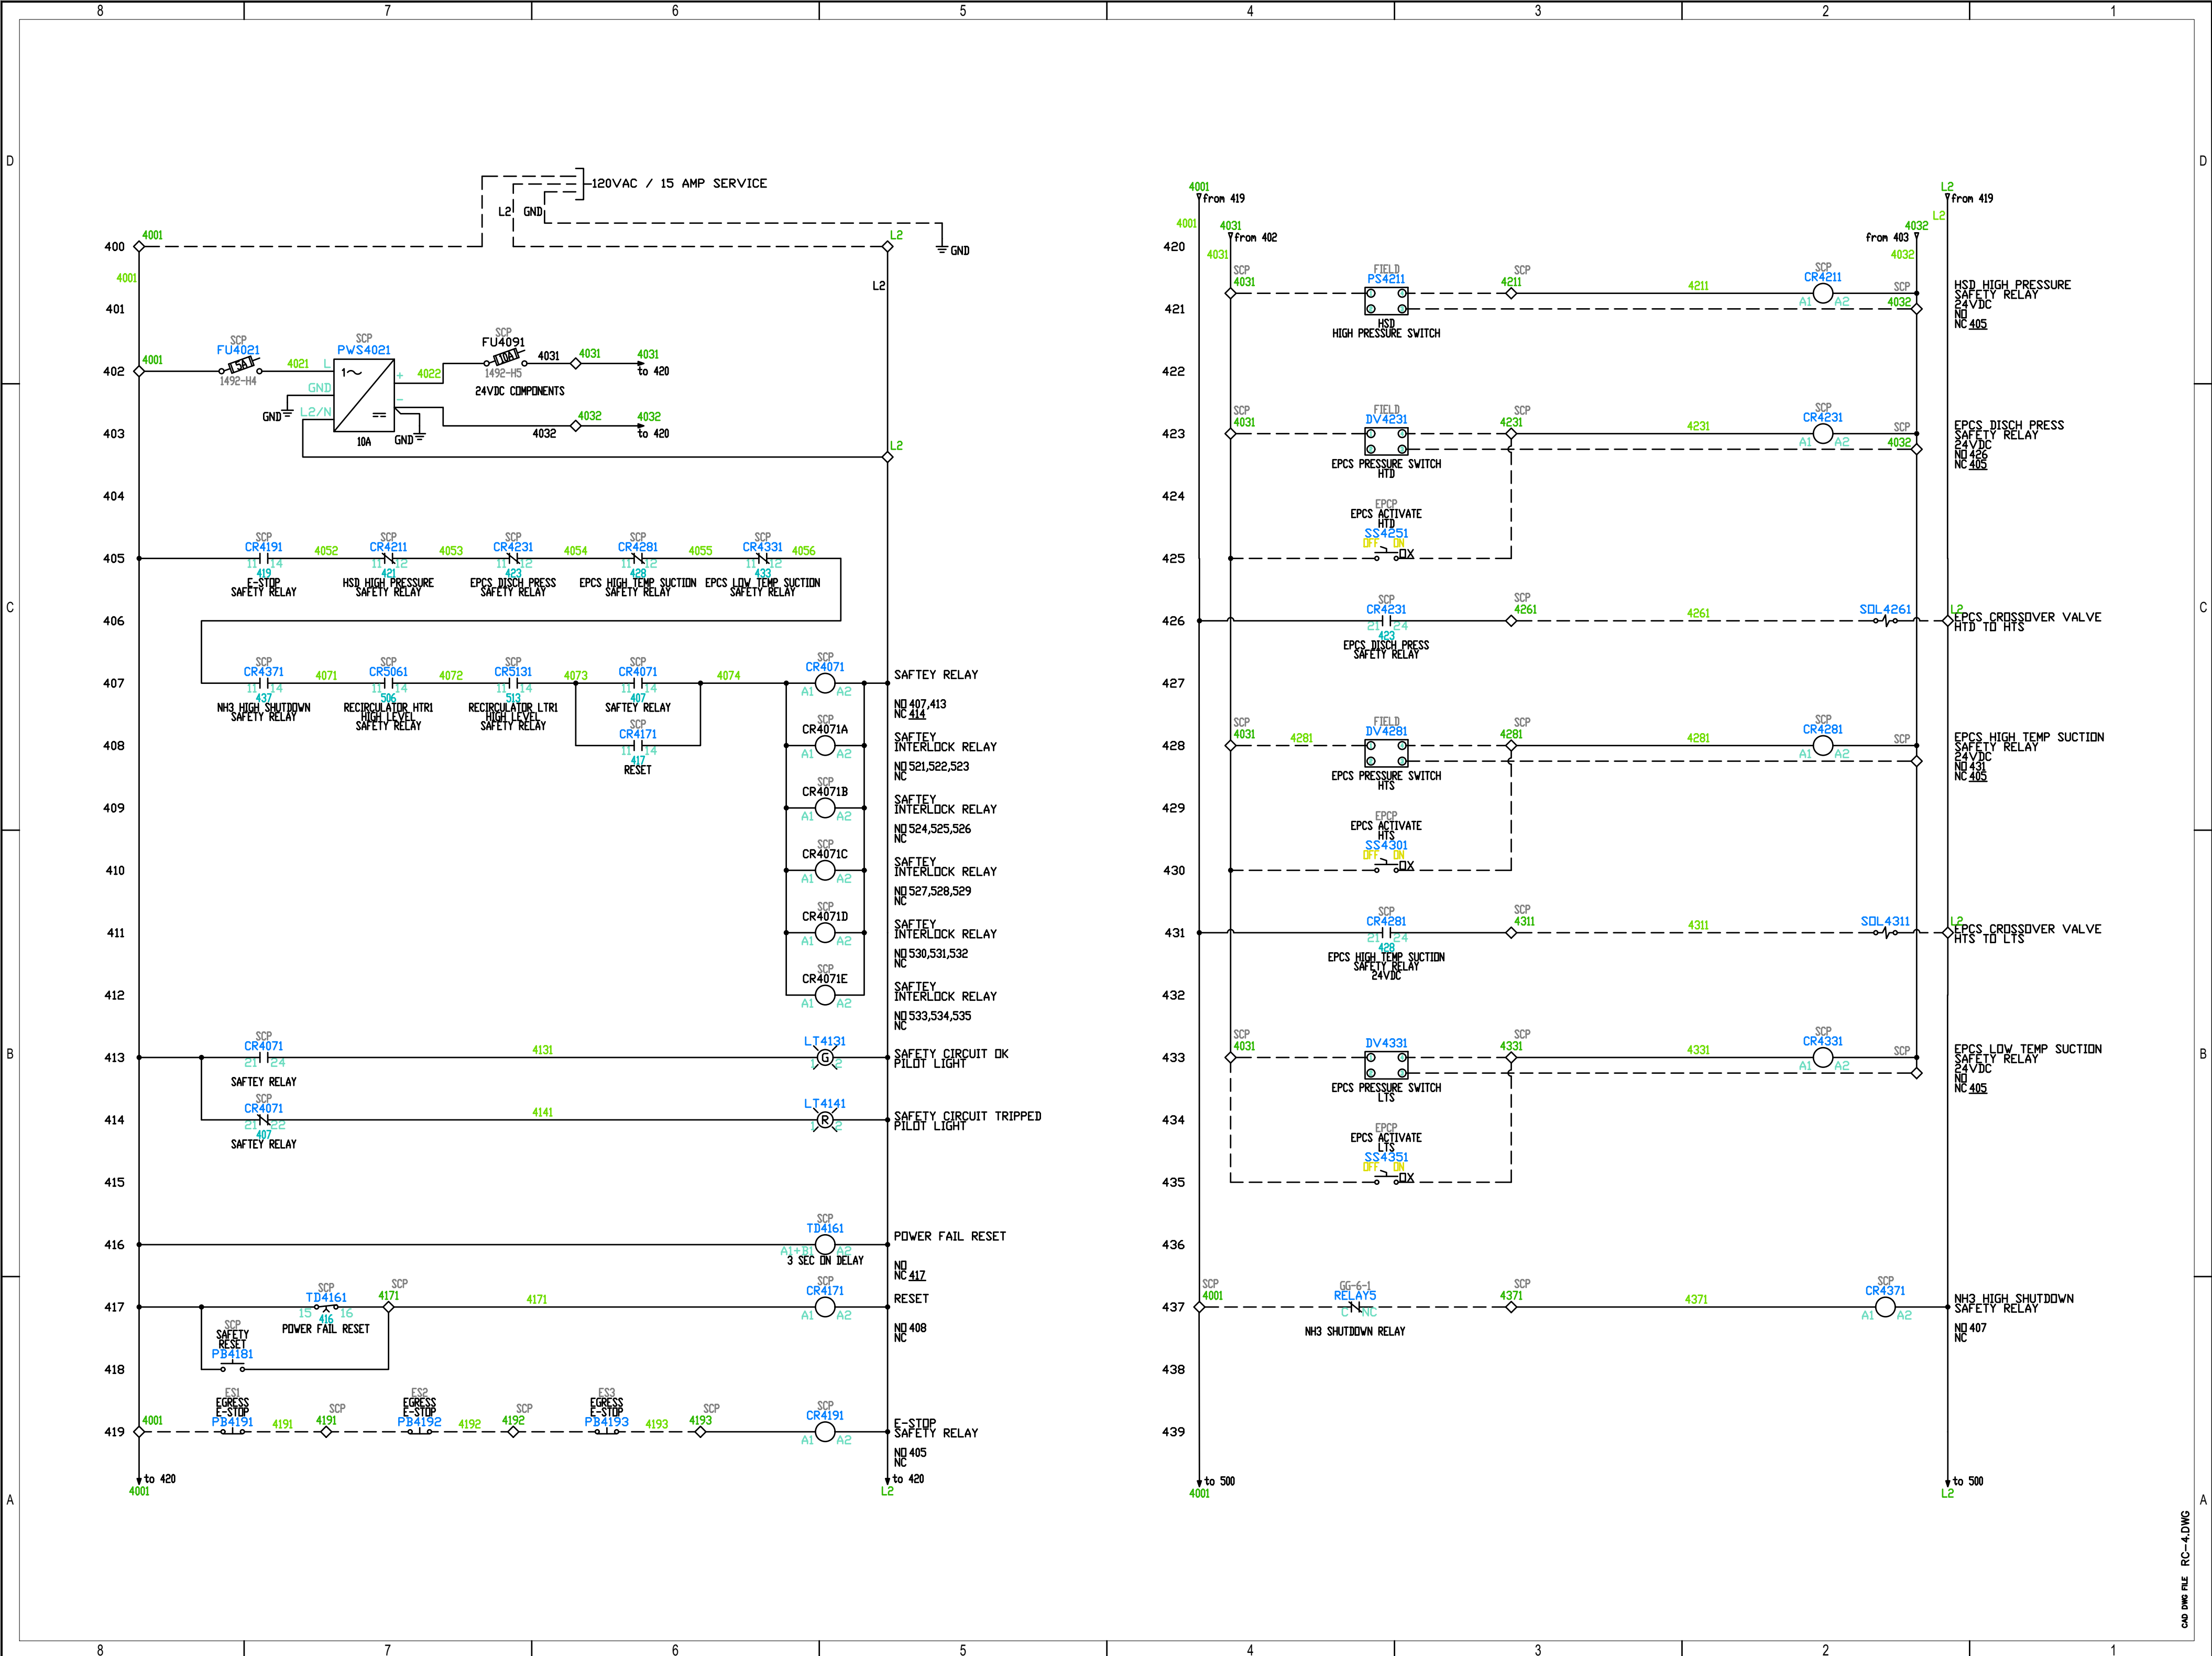

4487 S. Old Peachtree Rd.
Atlanta, GA 30327
Phone: 800.327.3517
Fax: 770.241.8894
www.unitemp.com

Uni-Temp
REFRIGERATION, INC.

WAYNE FARMS

Client:

Project:

REFRIGERATION SYSTEM
SAFETY CONTROL PANEL

WAYNE FARMS
UNION SPRINGS, AL

Rev	Date	By	App'd	Description
1	03/12/19	GG	GG	PRELIMINARY - FOR REVIEW ONLY
2	03/19/19	GG	GG	FOR CONSTRUCTION
3	04/10/19	GG	GG	FOR INSTALLATION
4	06/27/19	GG	GG	CORRECTIONS DURING INSTALLATION
5	10/18/19	GG	GG	AS INSTALLED

THIS DOCUMENT CONTAINING
PROPERTY INFORMATION BELONGING
TO UNI-TEMP REFRIGERATION, INC.
OR ITS AFFILIATED COMPANIES AND
SHALL BE USED ONLY FOR THE
PURPOSE FOR WHICH IT WAS
SUPPLIED. IT SHALL NOT BE COPIED,
REPRODUCED OR OTHERWISE USED,
FOR ANY OTHER PURPOSE, WITHOUT
THE WRITTEN CONSENT OF UNI-TEMP
REFRIGERATION, INC. ANY SUCH
VIOLATION SHALL BE AT THE USER'S
SOLE RISK AND WITHOUT LIABILITY
TO UNI-TEMP REFRIGERATION, INC.

Project No.: 3807

Drawn by: G Garrett

Dwg Date: 03/12/19


Proj. Engr: J Howell

Scale: NONE

Sheet No.: 4 OF 9

Sheet Title: Safety Circuit

Sheet Name: RC-4

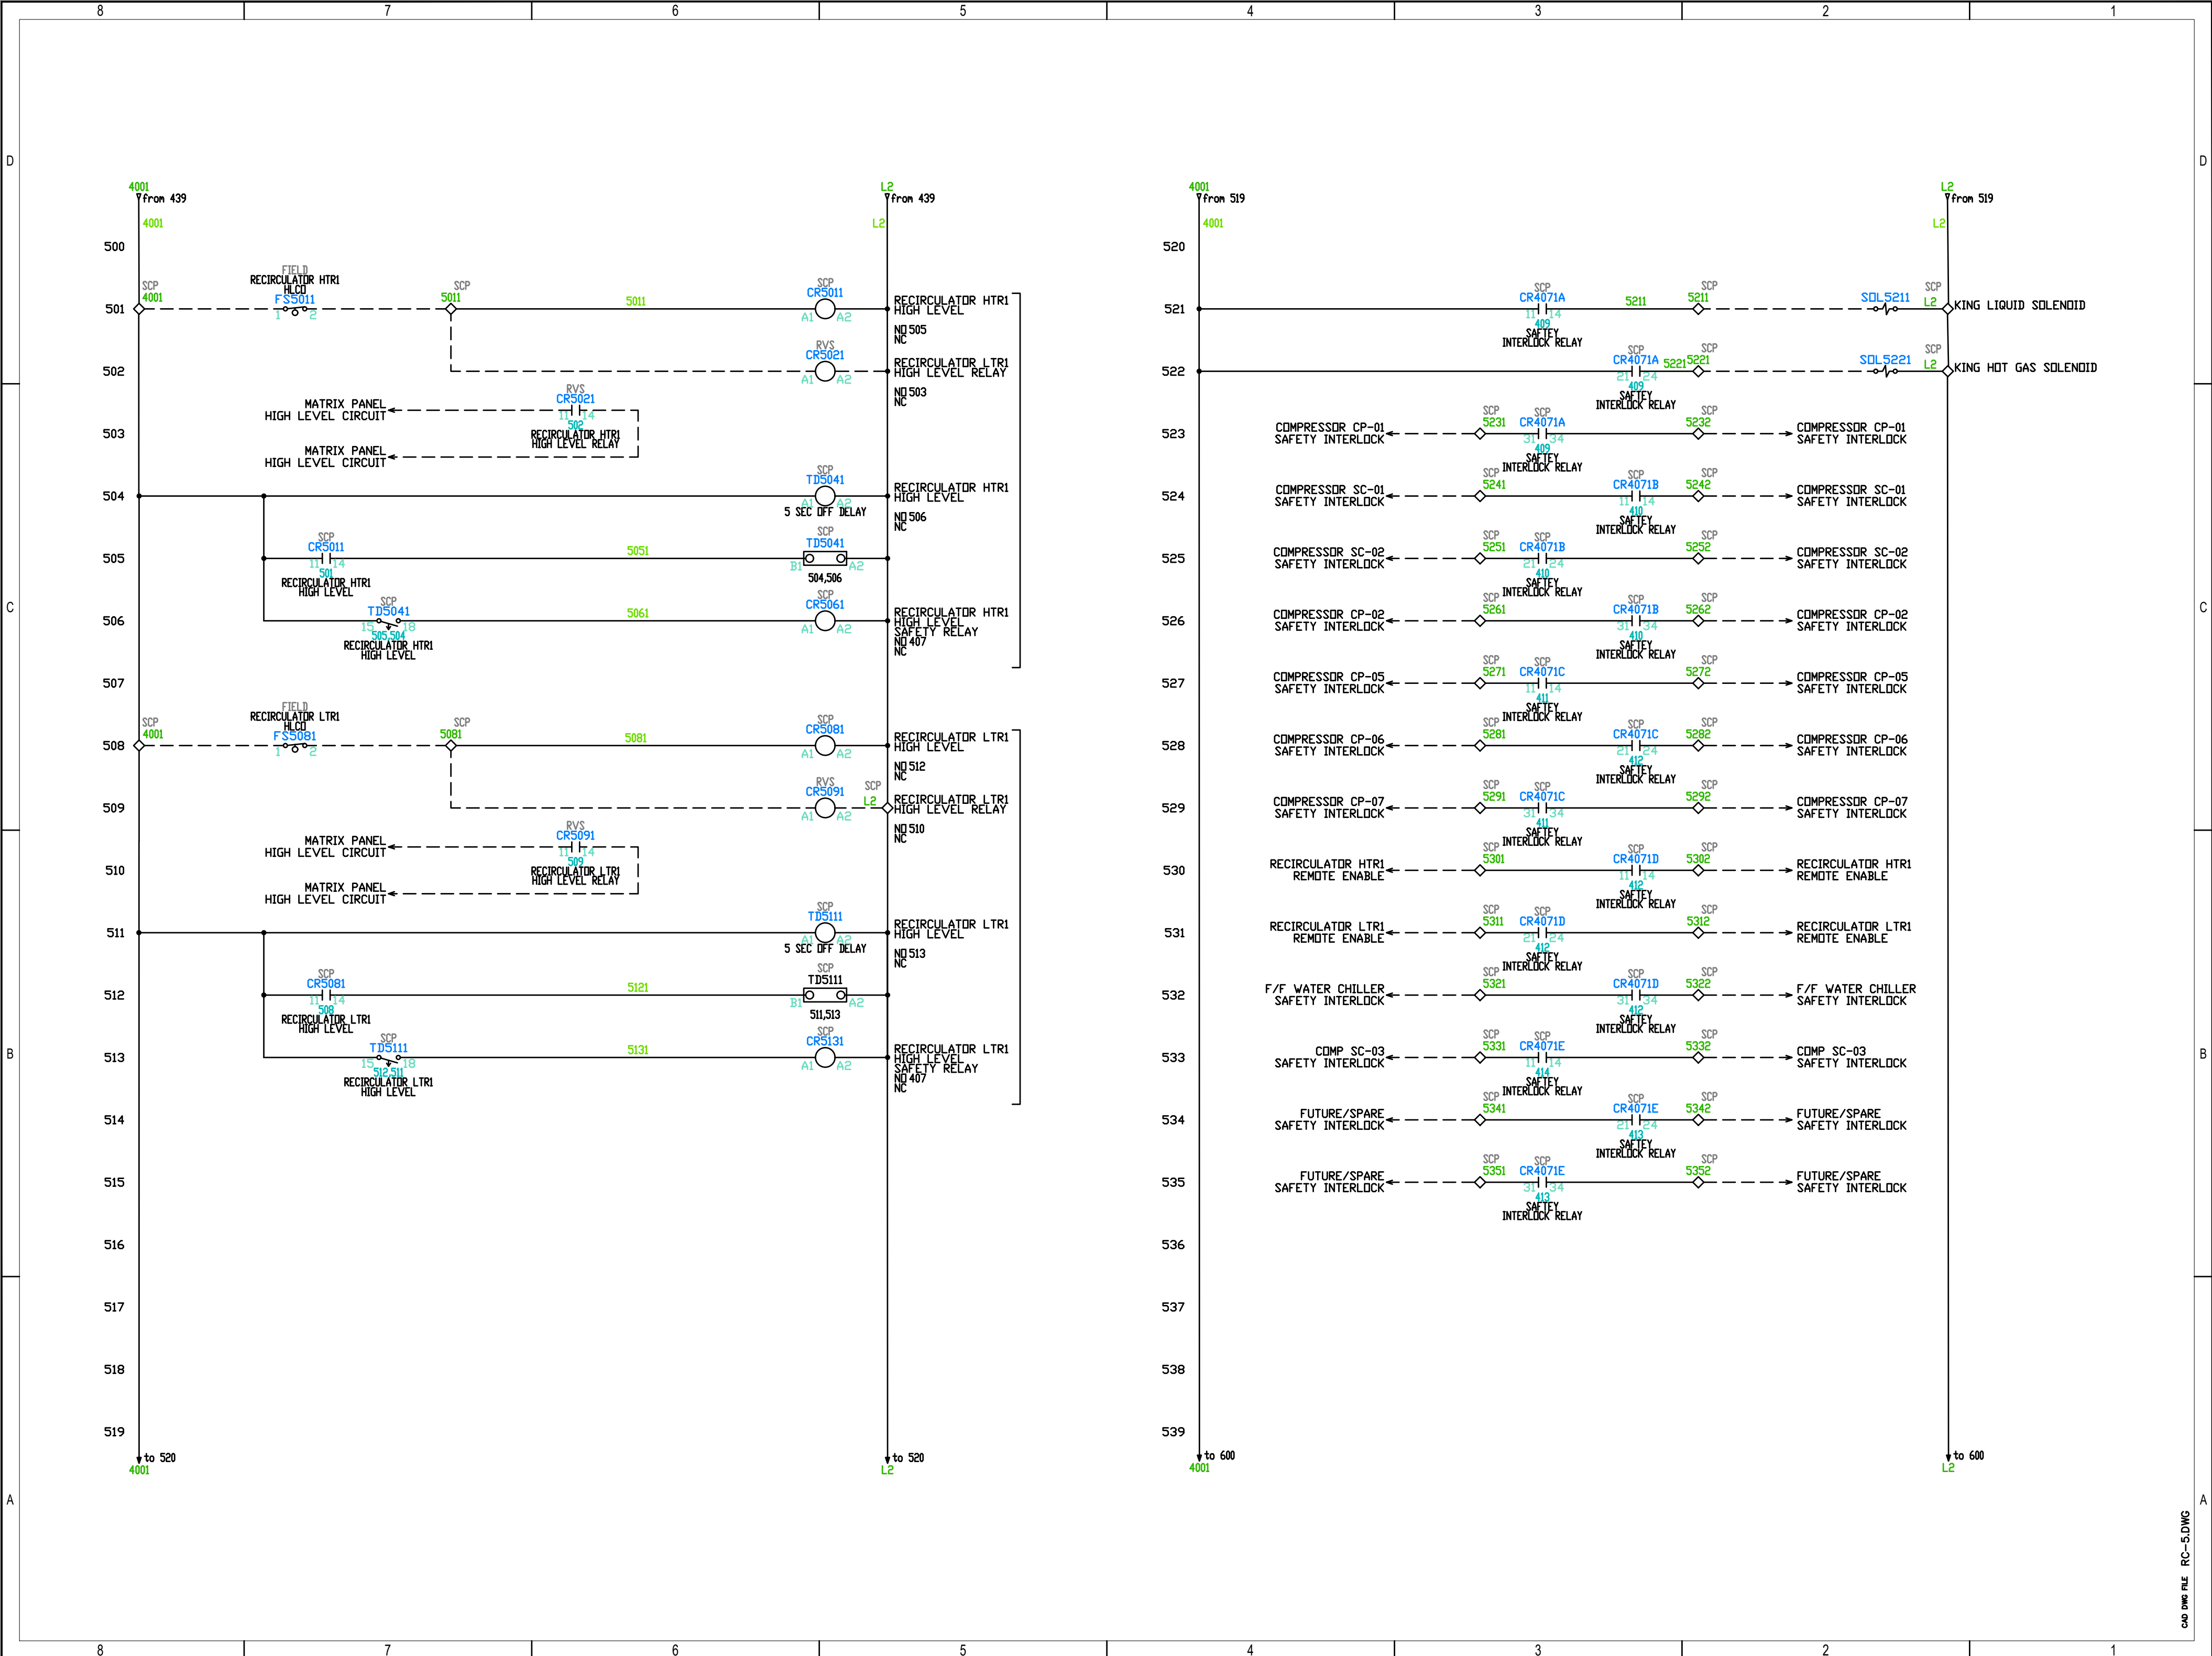

4487 S. Old Peachtree Rd.
Atlanta, Georgia 30327
Phone: 800.227.3517
Fax: 770.241.8884
www.unitemp.com

Client:

Project:

REFRIGERATION SYSTEM
SAFETY CONTROL PANEL
WAYNE FARMS
UNION SPRINGS, AL

Rev	Date	By	App'd	Description
1	03/12/19	GG	GG	PRELIMINARY - FOR REVIEW ONLY
2	03/19/19	GG	GG	FOR CONSTRUCTION
3	04/10/19	GG	GG	FOR INSTALLATION
4	06/27/19	GG	GG	CORRECTIONS DURING INSTALLATION
5	10/18/19	GG	GG	AS INSTALLED

THIS DOCUMENT CONTAINING
PROPERTY INFORMATION BELONGING
TO UNI-TEMP REFRIGERATION INC.
OR ITS AFFILIATED COMPANIES AND
SHALL BE USED ONLY FOR THE
PURPOSE FOR WHICH IT WAS
SUPPLIED. IT SHALL NOT BE COPIED,
REPRODUCED OR OTHERWISE USED,
NOR SUCH INFORMATION BE
FURNISHED IN WHOLE OR IN PART
TO OTHERS EXCEPT IN ACCORDANCE
WITH THE TERMS OF ANY AGREEMENT
UNDER WHICH IT WAS SUPPLIED OR
WITH PRIOR WRITTEN CONSENT OF
UNI-TEMP REFRIGERATION INC. AND
SHALL BE RETURNED UPON REQUEST.

Project No.: 3807

Drawn by: G Garrett

Dwg Date: 03/12/19


Prog. Engr: J Howell

Scale: NONE

Sheet No.: 5 OF 9

Sheet Title: Safety Circuit

Sheet Name: RC-5

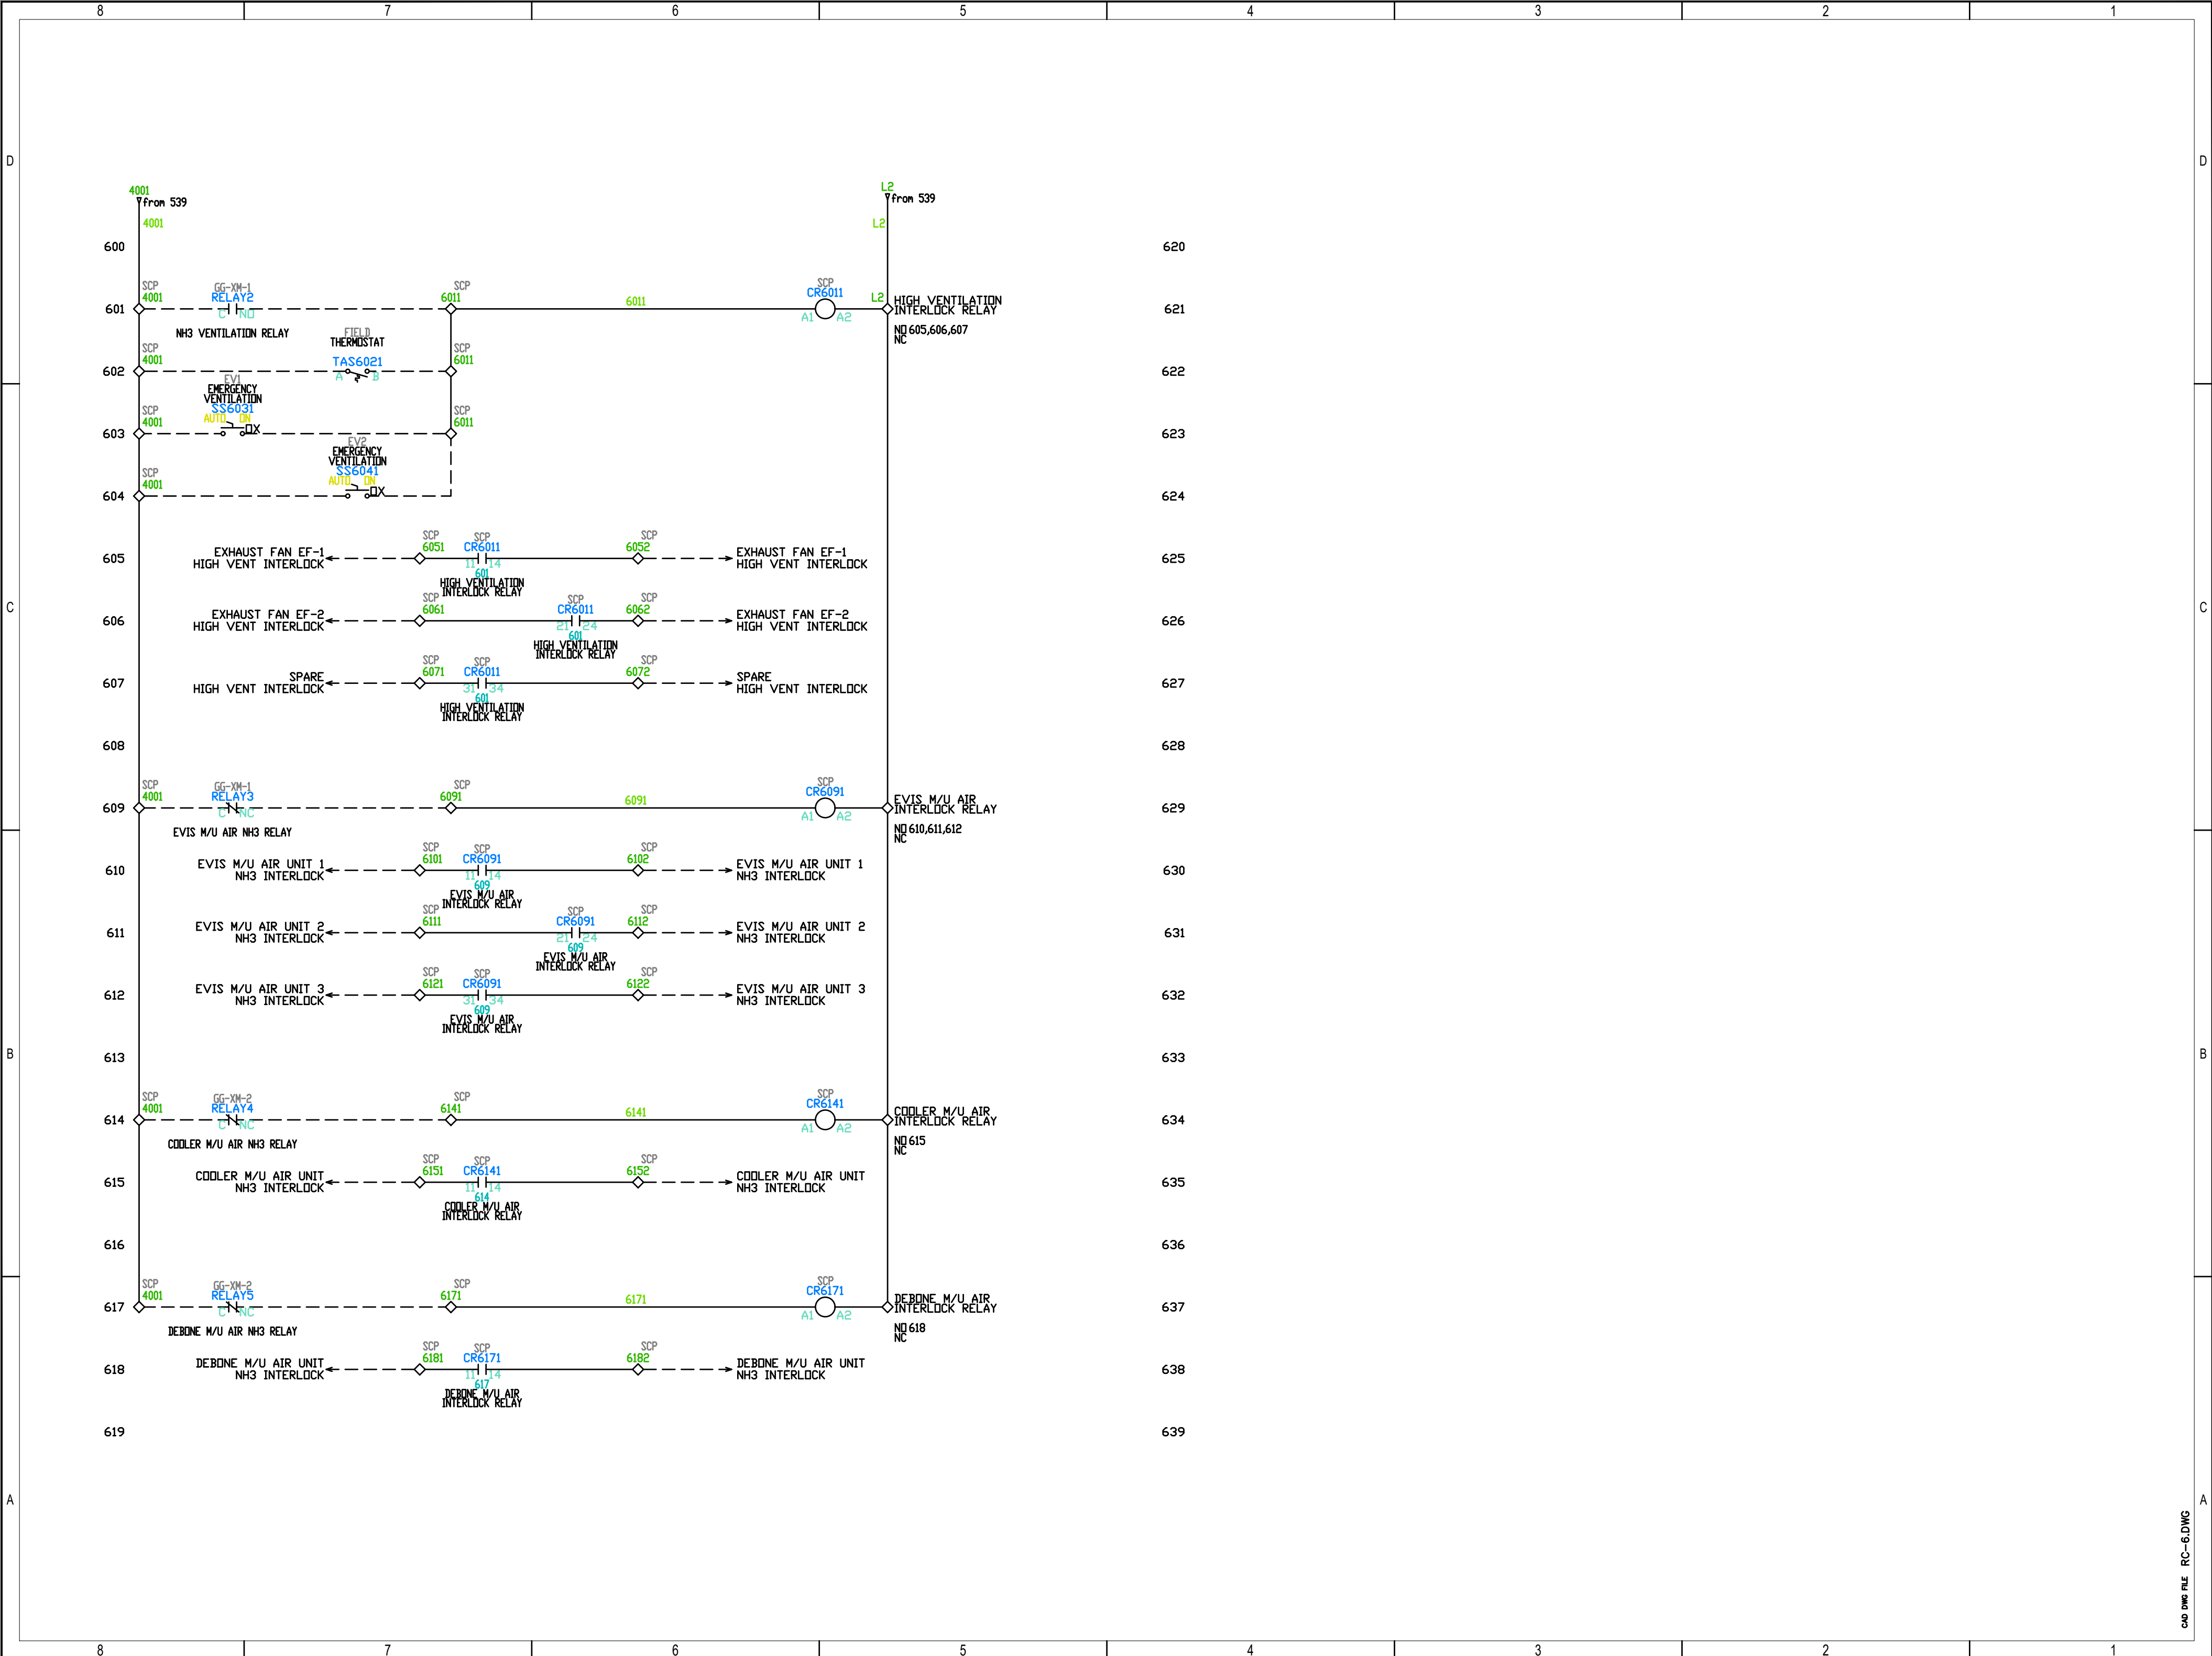

4487 S. Old Peachtree Rd.
Atlanta, Georgia 30327
Phone: 800.227.3517
Fax: 770.241.8894
www.unitemp.com

Uni-Temp
REFRIGERATION, INC.

WAYNE FARMS

Client:

Project:

REFRIGERATION SYSTEM
SAFETY CONTROL PANEL
WAYNE FARMS
UNION SPRINGS, AL


Rev	Date	By	App'd	Description
1	03/12/19	GG		PRELIMINARY - FOR REVIEW ONLY
2	03/19/19	GG		FOR CONSTRUCTION
3	04/10/19	GG		FOR INSTALLATION
4	08/27/19	GG		CORRECTIONS DURING INSTALLATION
5	10/18/19	GG		AS INSTALLED

THIS DOCUMENT CONTAINING
PROPERTY INFORMATION BELONGING
TO UNI-TEMP REFRIGERATION, INC.
OR ITS AFFILIATED COMPANIES AND
SHALL BE USED ONLY FOR THE
PURPOSE FOR WHICH IT WAS
SUPPLIED. IT SHALL NOT BE COPIED,
REPRODUCED OR OTHERWISE USED,
FURNISHED IN WHOLE OR IN PART,
TO OTHERS EXCEPT IN ACCORDANCE
WITH THE TERMS OF ANY AGREEMENT
UNDER WHICH IT WAS SUPPLIED OR
WITH PRIOR WRITTEN CONSENT OF
UNI-TEMP REFRIGERATION, INC. AND
SHALL BE RETURNED UPON REQUEST.

Project No.: 3807
Drawn by: G Garrett
Dwg Date: 03/12/19
Prog. Engr.: J Howell
Scale: NONE
Sheet No.: 6 OF 9
Sheet Title: Ventilation
Interlock
Wiring
Sheet Name: RC-6

RC-6

CAD DWG FILE RC-6.DWG

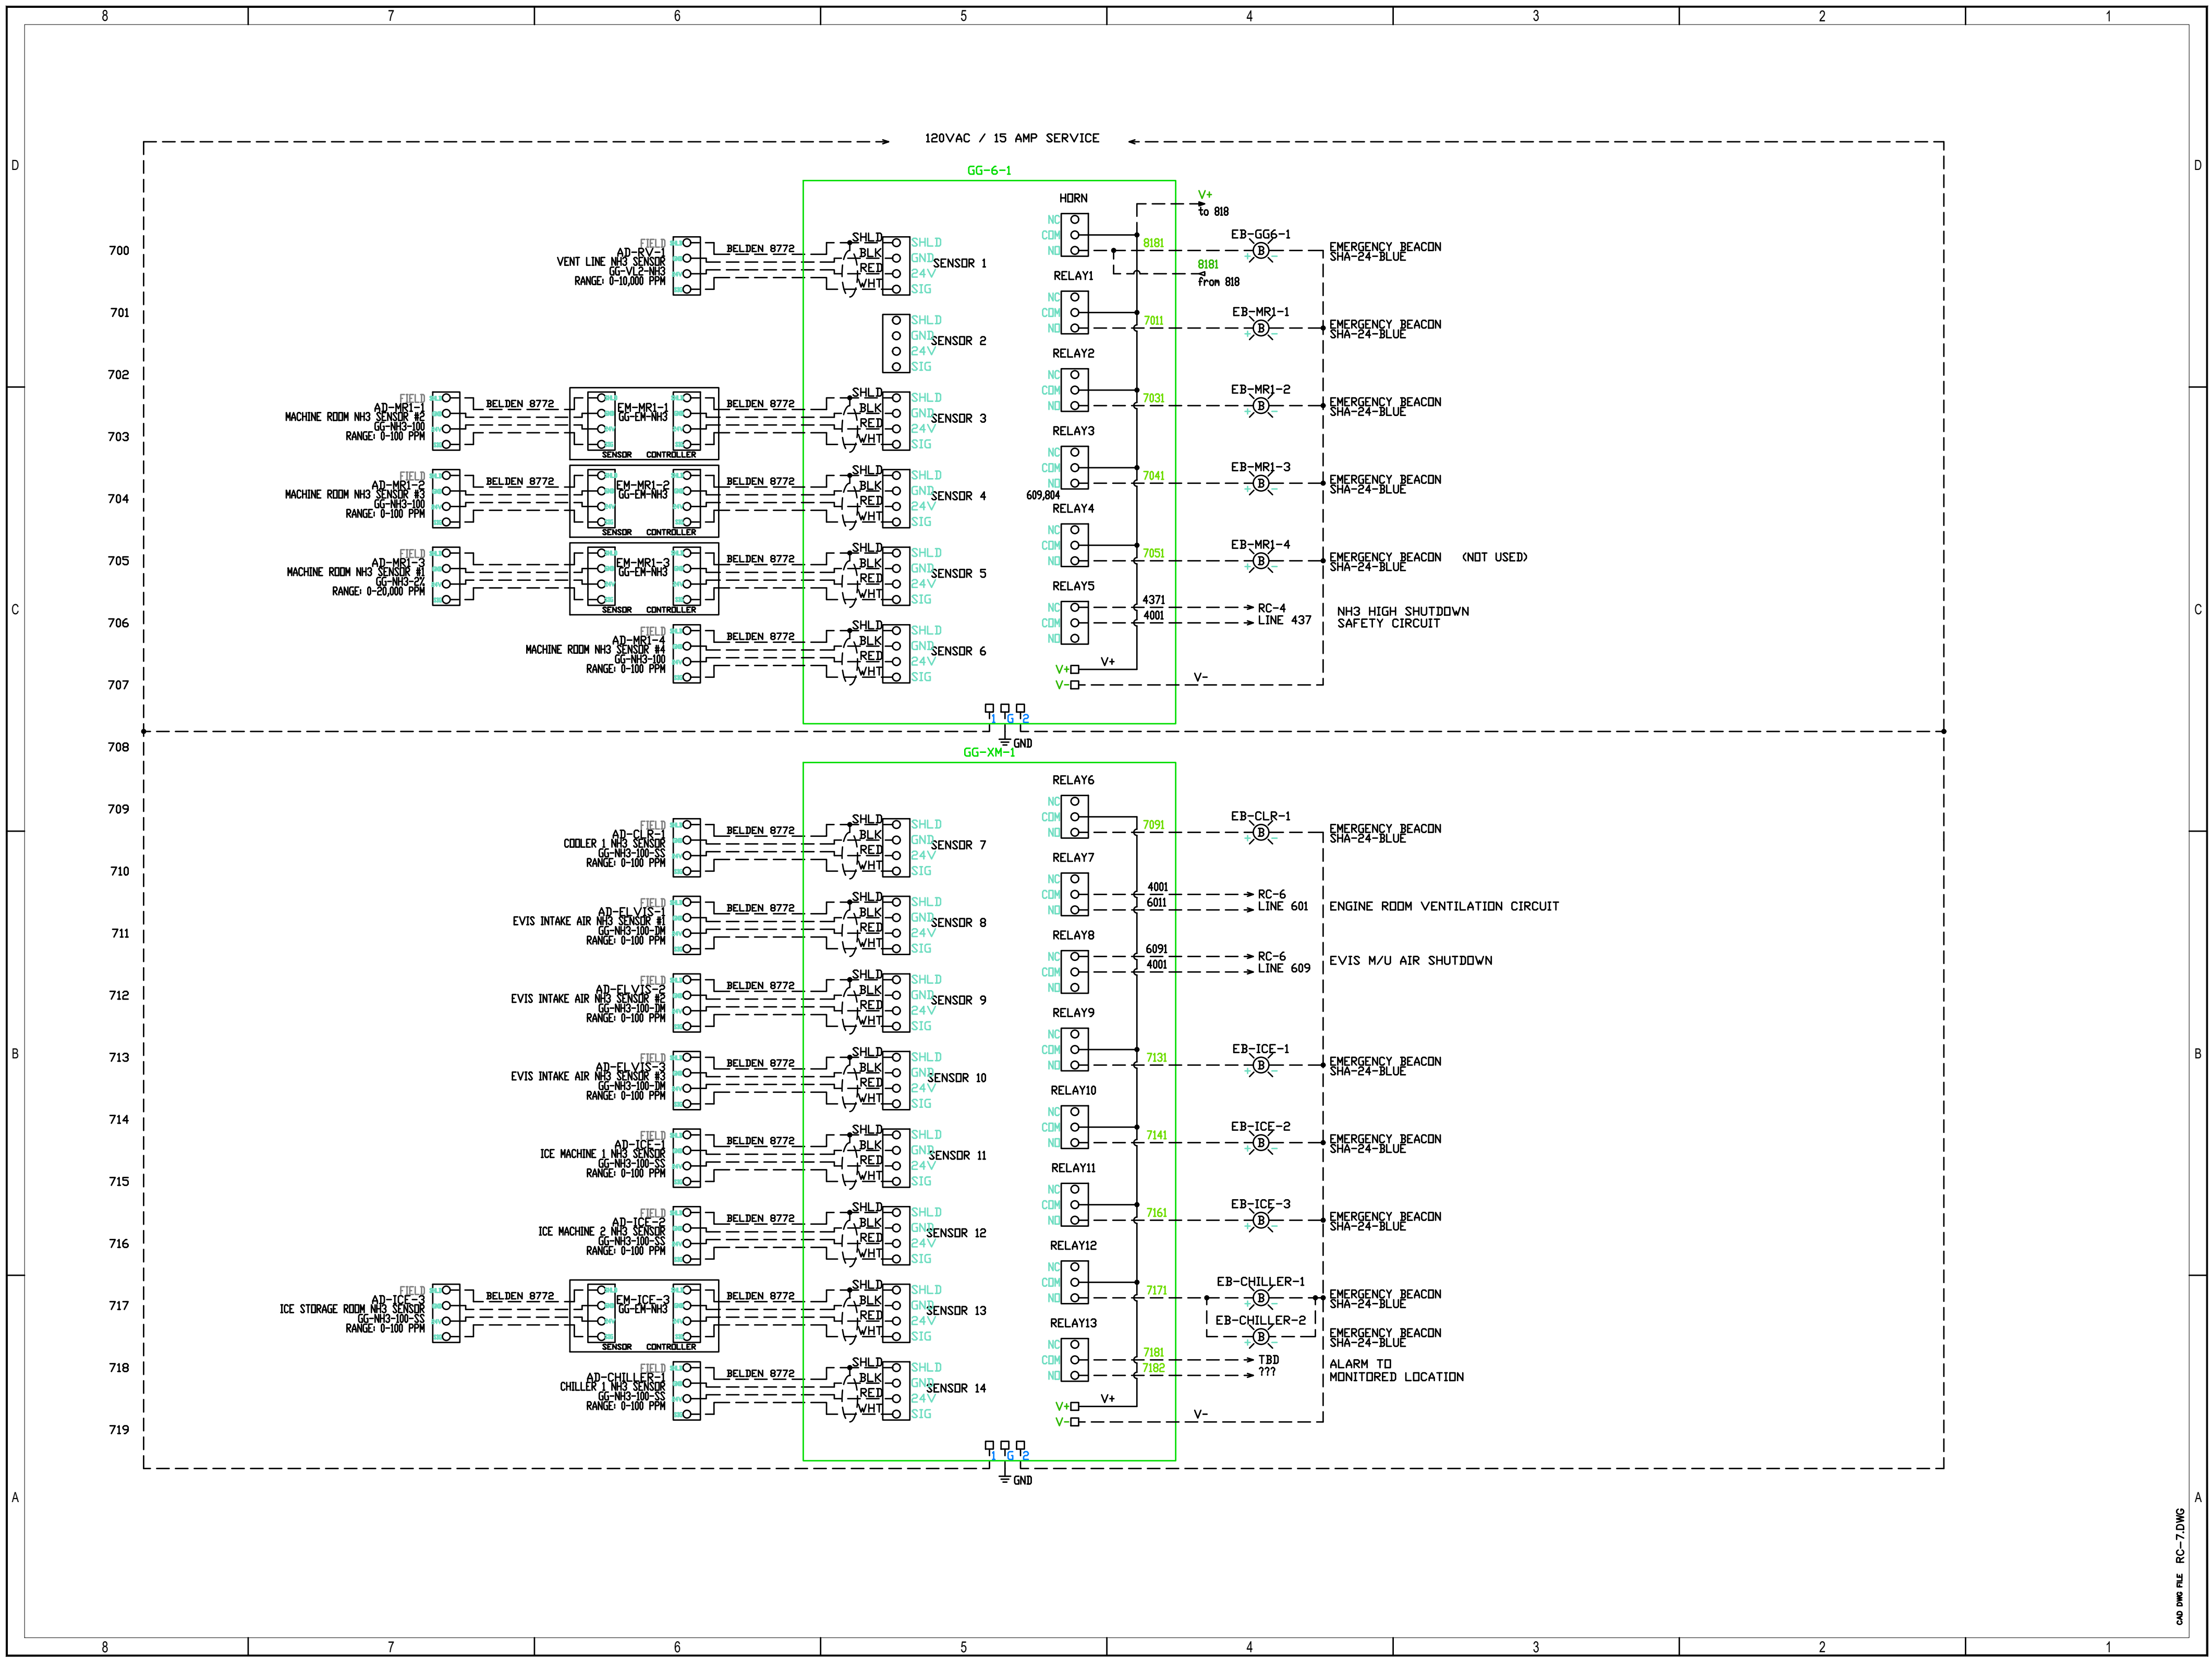

4487 S. Old Peachtree Rd.
Atlanta, GA 30327
Phone: 800.327.3517
Fax: 770.241.8894
www.uni-temp.com

Uni-Temp
REFRIGERATION, INC.

WAYNE FARMS

Client:

Project:

REFRIGERATION SYSTEM
SAFETY CONTROL PANEL

WAYNE FARMS
UNION SPRINGS, AL

Rev	Date	By	App'd	Description
1	03/12/19	GG	GG	PRELIMINARY - FOR REVIEW ONLY
2	03/12/19	GG	GG	FOR CONSTRUCTION
3	04/10/19	GG	GG	FOR INSTALLATION
4	08/27/19	GG	GG	CORRECTIONS DURING INSTALLATION
5	10/18/19	GG	GG	AS INSTALLED

THIS DOCUMENT CONTAINING
PROPERTY INFORMATION BELONGING
TO UNI-TEMP REFRIGERATION INC.
OR ITS AFFILIATED COMPANIES AND
SHALL BE USED ONLY FOR THE
PURPOSE FOR WHICH IT WAS
SUPPLIED. IT SHALL NOT BE COPIED,
REPRODUCED OR OTHERWISE USED,
NOR SUCH INFORMATION BE
FURNISHED IN WHOLE OR IN PART
TO OTHERS EXCEPT IN ACCORDANCE
WITH THE TERMS OF ANY AGREEMENT
UNDER WHICH IT WAS SUPPLIED OR
WITH PRIOR WRITTEN CONSENT OF
UNI-TEMP REFRIGERATION INC. AND
SHALL BE RETURNED UPON REQUEST.

Project No.: 3807

Drawn by: G Garrett

Dwg Date: 03/12/19

Prog. Engr: J Howell

Scale: NONE

Sheet No.: 7 OF 9

Sheet Title: Ammonia
Monitoring
Station

Sheet Name: RC-7

CAD DWG FILE RC-7.DWG

